

Give All Information Completely
Make Required Affidavit
Mail or Deliver Report to:
Conservation Division
State Corporation Commission
212 No. Market
Wichita, Kansas

WELL PLUGGING RECORD

Seward County, Sec. 5 Twp. 32 Rge. 33 (W)

Location as "NE/CNW/SW" or footage from lines C SW

Lease Owner Panhandle Eastern Pipe Line Company

Lease Name Morgan Well No. 1

Office Address P. O. Box 828, Liberal, Kansas 67901

Character of Well (completed as Oil, Gas or Dry Hole) Gas

Date well completed January 7 19 58

Application for plugging filed November 10 19 69

Application for plugging approved November 12 19 69

Plugging commenced November 15 19 69

Plugging completed November 17 19 69


Reason for abandonment of well or producing formation

Casing leak, replacement well drilled

If a producing well is abandoned, date of last production 19

Was permission obtained from the Conservation Division or its agents before plugging was commenced? yes

NORTH

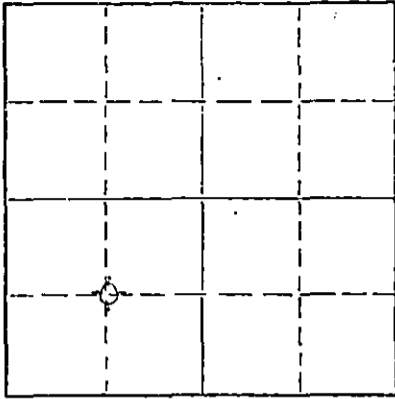

Locate well correctly on above Section Plat

Name of Conservation Agent who supervised plugging of this well Edgar J. Eves

Producing formation Hugoton Depth to top 2558' Bottom 2649' Total Depth of Well 2710 Feet

Show depth and thickness of all water, oil and gas formations.

OIL, GAS OR WATER RECORDS

CASING RECORD

FORMATION	CONTENT	FROM	TO	SIZE	PUT IN	PULLED OUT
Herington	Gas	2530'	2544'	8-5/8"	542'	0
Krider	Gas	2558'	2618'	4-1/2"	2705'	892'
Winfield	Gas	2633'	2660'			

Describe in detail the manner in which the well was plugged, indicating where the mud fluid was placed and the method or methods used in introducing it into the hole. If cement or other plugs were used, state the character of same and depth placed, from feet to feet for each plug set.

Measured hole, bottom at 895'. Shot pipe loose at 892', laid down 1 joint, mixed and circulated mud, but got oil back. Spotted 30 sacks cement at 840'. Pulled 11 joints or 275' of 4-1/2" casing. Spotted 35 sacks cement. Pulled all 4-1/2", put 15 sacks cement from 45 to 0'. Cut off surface casing and welded on cap.

RECEIVED
STATE CORPORATION COMMISSION
NOV 26 1969
CONSERVATION DIVISION
Wichita, Kansas

(If additional description is necessary, use BACK of this sheet)
Name of Plugging Contractor Sargent's Casing Pulling Service
Address P. O. Box 506, Liberal, Kansas 67901

STATE OF Kansas COUNTY OF Seward ss.
I, Jack P. Phillippe, (employee of Panhandle Eastern Pipe Line Co. or owner or operator) of the above-described well, being first duly sworn on oath, says: That I have knowledge of the facts, statements, and matters herein contained and the log of the above-described well as filed and that the same are true and correct. So help me God.

(Signature) Jack P. Phillippe, Manager Drilling & Prod.
P. O. Box 828, Liberal, Kansas 67901
(Address)

SUBSCRIBED AND SWORN TO before me this 25th day of November, 19 69

My commission expires November 12, 1977

Notary Public.