

15-175-20274-0000

WELL PLUGGING RECORD

Give All Information Completely
Make Required Affidavit
Mail or Deliver Report to:
Conservation Division
State Corporation Commission
212 No. Market
Wichita, Kansas

SEWARD County. Sec. 7 Twp 32 Rge. 33 (E) (W)

Location as "NE/CNWSW" or footage from lines SW/4 NE/4

Lease Owner ANADARKO PRODUCTION COMPANY

Lease Name BOLES "B" Well No. 1

Office Address P. O. BOX 351, LIBERAL, KANSAS 67901

Character of Well (completed as Oil, Gas or Dry Hole) Dry Hole

Date well completed 1-19 19 76

Application for plugging filed Verbal 1-6-76 19

Application for plugging approved 1-20-76 19


Plugging commenced 1-19-76 19

Plugging completed 2 PM 1-19-76 19

Reason for abandonment of well or producing formation

If a producing well is abandoned, date of last production 19

Was permission obtained from the Conservation Division or its agents before plugging was commenced? Yes, confirmation received 1-6-76

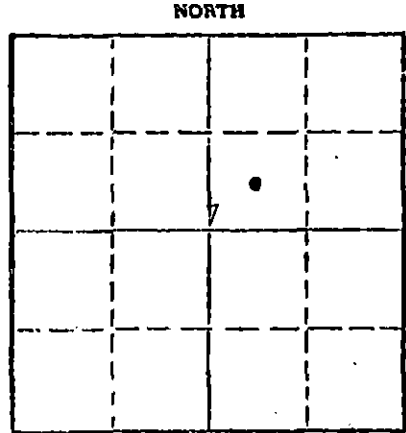

Locate well correctly on above Section Plat

Name of Conservation Agent who supervised plugging of this well Clarence Thomas

Producing formation Depth to top Bottom Total Depth of Well 5730 Feet

Show depth and thickness of all water, oil and gas formations.

OIL, GAS OR WATER RECORDS

CASING RECORD

FORMATION	CONTENT	FROM	TO	SIZE	PUT IN	PULLED OUT

Describe in detail the manner in which the well was plugged, indicating where the mud fluid was placed and the method or methods used in introducing it into the hole. If cement or other plugs were used, state the character of same and depth placed, from feet to feet for each plug sqt.
Spotted 50 sxs cmt 1500', 25 sxs 40--0', comp 2 PM 1/19/76 P&A.

(If additional description is necessary, use BACK of this sheet)

Name of Plugging Contractor Gabbert-Jones, Inc.

Address 830 Sutton Place, Wichita, Kansas 67202

STATE OF KANSAS COUNTY OF SEWARD, ss.

(employee of owner) or (owner or operator) of the above-described well, being first duly sworn on oath, says: That I have knowledge of the facts, statements, and matters herein contained and the log of the above-described well as filed and that the same are true and correct. So help me God.

(Signature) Stanley R. Shoemaker
P. O. Box 351, Liberal, Ks. 67901
(Address)

SUBSCRIBED AND SWORN TO before me this 30th day of March 19 76

My commission expires
NORMA JEAN TUCKER
NOTARY PUBLIC
Seward County, Kansas
My Commission Expires
September 9, 1976

Notary Public