


STATE OF KANSAS
STATE CORPORATION COMMISSION

Give All Information Completely
Make Required Affidavit
Mail or Deliver Report to:
Conservation Division
State Corporation Commission
800 Bittling Building
Wichita, Kansas

WELL PLUGGING RECORD

NORTH

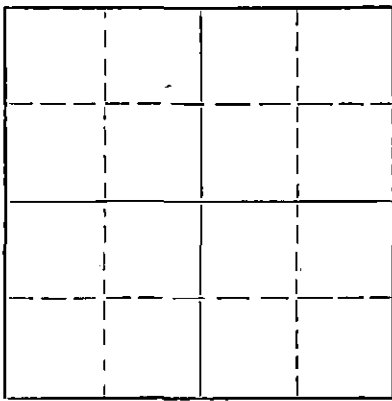

Locate well correctly on above
Section Plat

Sedgwick County. Sec. 17 Twp. 29 Rge. 3 (E) 3 (W)
Location as "NE/CNW/SW" or footage from lines NW NW NW
Lease Owner Earl F. Wakefield
Lease Name More Well No. 1
Office Address Union Nat'l Bank Bldg., Wichita, Kansas
Character of Well (completed as Oil, Gas or Dry Hole) Dry Hole
Date well completed May 17 1953
Application for plugging filed " " 1953
Application for plugging approved " " 1953
Plugging commenced " " 1953
Plugging completed " " 1953
Reason for abandonment of well or producing formation _____

If a producing well is abandoned, date of last production _____ 19____
Was permission obtained from the Conservation Division or its agents before plugging was commenced? Yes

Name of Conservation Agent who supervised plugging of this well Ruel Durkee
Producing formation _____ Depth to top _____ Bottom _____ Total Depth of Well 4355 Feet
Show depth and thickness of all water, oil and gas formations.

OIL, GAS OR WATER RECORDS

CASING RECORD

FORMATION	CONTENT	FROM	TO	SIZE	PUT IN	PULLED OUT
				8 5/8	140	None

Describe in detail the manner in which the well was plugged, indicating where the mud fluid was placed and the method or methods used in introducing it into the hole. If cement or other plugs were used, state the character of same and depth placed, from _____ feet to _____ feet for each plug set.

Filled with Heavy Rotary Mud from 4355 feet to 150 feet, Bridged with Halliburton Plug & 1/8 Sk Hulls and cemented with 15 sacks, heavy mud to 40 feet Halliburton Plug, 1/8 sack hulls & 10 sacks cement to bottom of cellar.

5-23-53

(If additional description is necessary, use BACK of this sheet)
Name of Plugging Contractor Earl F. Wakefield
Address 307 Union Nat'l Bank Bldg., Wichita, Kansas

STATE OF Kansas, COUNTY OF Sedgwick, ss.
Earl F. Wakefield (owner or operator) of the above-described well, being first duly sworn on oath, says: That I have knowledge of the facts, statements, and matters herein contained and the log of the above-described well as filed and that the same are true and correct. So help me God.

(Signature) Earl F. Wakefield
307 Union Nat'l Bank Bldg.
Wichita, Kansas (Address)

SUBSCRIBED AND SWORN TO before me this 18th day of May 1953

My commission expires 12-23-54

24-2675-5 2-52-26M

Notary Public.

PLUGGING
FILE SEC 17 T 29 R 34
BOOK PAGE 101 LINE 31

More #1
 Owner: Earl F. Wakefield
 Contractor: Earl F. Wakefield
 Comm: 4/30/53 Comp: 5/16/53

NW NW NW 17-29-3W
 Sedgwick County, Kansas
 Casing: 140' of 8 5/8"

Elevation: 1318 D.F.

Keel	40
Shale & Shells	102
Shale & Lime Shells	140
Shale & Shells	890
Sandy Shale	980
Shale & Shells	1165
Lime & Shale	1585
Sdy. Shale & Lime	1900
Shale & Lime	2140
Sandy Shale & Lime	2378
Shale & Lime	2540
Sandy Shale & Lime	2765
Shale & Lime	2885
Sandy Lime	2960
Sandy Lime & Shale	3147
Lime (K.O.)	3298
Sandy Lime & Shale	3326
Shale & Lime	3761
Lime (Mississippi)	3915
Sandy Shale & Lime	4004
Lime & Shale	4042
Cherty Lime & Shale	4061
Lime	4090
Shale & Lime	4130
Black Shale & Lime	4159
Shale	4215
Sand (Simpson)	4223
Sandy Shale	4325
Lime (Arbuckle)	4355
Total Depth	4355

STATE OF KANSAS)
) ss
 COUNTY OF SEDGWICK)

I hereby agree and certify that the above is a true and correct copy of the log on the More #1 well located NW NW NW 17-29-3W, Sedgwick County, Kansas.

Earl F. Wakefield

Sworn and subscribed before me this 21st day of May, 1953.

Ed James Gaffney

My Commission Expires: 12-23-54

PLUGGING
 FILE SEC-17-T29-R3-W
 BOOK PAGE 101-LINE 21