


STATE OF KANSAS
STATE CORPORATION COMMISSION

WELL PLUGGING RECORD

Give All Information Completely
Make Required Affidavit
Mail or Deliver Report to
Conservation Division
State Corporation Comm.
245 North Water
Wichita, KS 67202

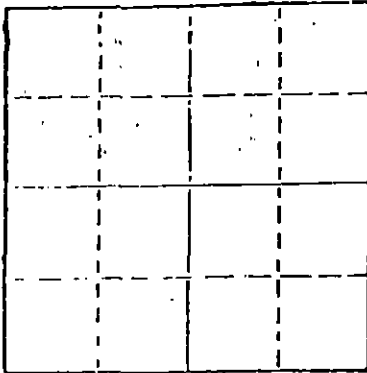

Locate well correctly on above
Section Plot

Sedgwick County, Sec. 13 Twp. 29S Rge. 3W E/W
Location as "NE/CNW/SW" or footage from lines
SW SE SW
Lease Owner C Oil, Inc.
Lease Name Clausen Well No. 1
Office Address 710 Petroleum Bldg., Wichita, Kansas 67202
Character of Well (Completed as Oil, Gas or Dry Hole)
Dry Hole
Date Well completed May 13, 19 80
Application for plugging filed May 13 19 80
Application for plugging approved May 13 19 80
Plugging commenced May 13 19 80
Plugging completed May 13 19 80
Reason for abandonment of well or producing formation

If a producing well is abandoned, date of last production 19

Was permission obtained from the Conservation Division or its agents before plugging was commenced? Yes

Name of Conservation Agent who supervised plugging of this well Barnett
Producing formation Depth to top Bottom Total Depth of Well 4170'
Show depth and thickness of all water, oil and gas formations.

OIL, GAS OR WATER RECORDS

CASING RECORD

FORMATION	CONTENT	FROM	TO	SIZE	PUT IN	PULLED OUT
				8-5/8"	526'	-0-

Describe in detail the manner in which the well was plugged, indicating where the mud fluid was placed and the method or methods used in introducing it into the hold. If cement or other plugs were used, state the character of same and depth placed, from feet to feet for each plug set.

Plugged w/35 sx @ 535'
Bridge to hold kelly @ 40'
w/10 sx
3 sx in rathole

RECEIVED
STATE CORPORATION COMMISSION

JUN 24 1980

(If additional description is necessary, use BACK of this sheet) DIVISION

Name of Plugging Contractor B & B Drilling, Inc. Wichita, Kansas

STATE OF KANSAS COUNTY OF SEDGWICK, ss.
Bill Lahar (employee of owner) or (owner or operator)
of the above-described well, being first duly sworn on oath, says: That I have knowledge of the facts, statements, and matters herein contained and the log of the above-described well as filed and that the same are true and correct. So help me, God.

(Signature)

515 Union Center, Wichita, Kansas 67202
(Address)

SUBSCRIBED AND SWORN TO before me this 20th day of May, 19 80

Betty M. Abbott

Notary Public.

My commission expires January 22, 1983



DRILLERS LOG

May 20, 1980

#1 Clausen
SW SE SW
Sec. 13-29S-3W
Sedgwick County, Kansas


OPERATOR: C Oil, Inc.
CONTRACTOR: B & B Drilling, Inc.
COMMENCED: April 30, 1980
COMPLETED: May 13, 1980

8-5/8" @ 526' w/300 sx common

0	250	Lime & Shale	
250	732	Shale & Lime	
732	1160	Shale & Sand	
1160	1450	Lime & Shale	
1450	2575	Shale & Lime	
2575	2981	Lime & Shale	
2981	3109	Kansas City	
3109	3227	Lime	
3227	4095	Lime & Shale	
4095	4155	Lime & Sand	
4155	4170	Lime & Shale	
4170		RTD	D & A

We certify that the above and foregoing is a true and correct copy of the log on the #1 Clausen located in Sedgwick County, Kansas.

B & B DRILLING, INC.

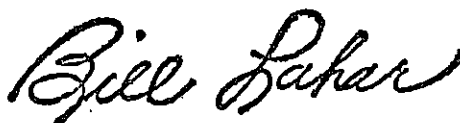

Bill Lahar

President

Subscribed and sworn to before me this 20th day of May, 1980.




Betty M. Abbott Notary Public