


STATE OF KANSAS  
STATE CORPORATION COMMISSION

Give All Information Completely  
Make Required Affidavit  
Mail or Deliver Report to:  
Conservation Division  
State Corporation Commission  
211 No. Broadway  
Wichita, Kansas

WELL PLUGGING RECORD

Seward County, Sec. 4 Twp. 32 Rge. 33 (W)

Location as "NE/CNW/SW" or footage from lines 150'S & 150'W of Center  
Lease Owner Stanolind Oil and Gas Company  
Lease Name Jarrett Gas Unit Well No. 1  
Office Address Box 591 Tulsa, Oklahoma  
Character of Well (completed as Oil, Gas or Dry Hole) Gas  
Date well completed April 25, 1954 19  
Application for plugging filed November 10, 1955 19  
Application for plugging approved November 14, 1955 19  
Plugging commenced November 14, 1955 19  
Plugging completed November 14, 1955 19  
Reason for abandonment of well or producing formation Non-commercial production found in testing

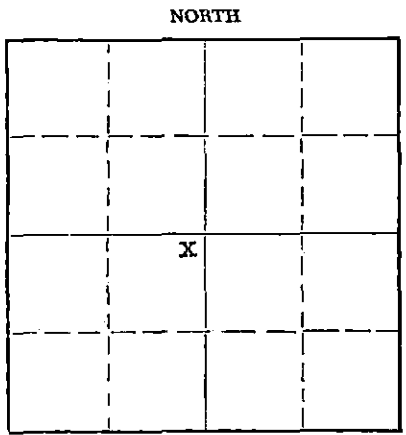

Locate well correctly on above Section Plat

If a producing well is abandoned, date of last production June 19 55  
Was permission obtained from the Conservation Division or its agents before plugging was commenced? Yes

Name of Conservation Agent who supervised plugging of this well Agent located at Pratt, Kansas (M. A. Rives)  
Producing formation Permian Depth to top -- Bottom -- Total Depth of Well 2697 Feet  
Show depth and thickness of all water, oil and gas formations.


OIL, GAS OR WATER RECORDS

CASING RECORD

FORMATION	CONTENT	FROM	TOP	SIZE	PUT IN	PULLED OUT *
Herington	No Comm. Prod.		2622	8-5/8"	600	None
Krider	" " "		2665	5 1/2"	2676	None
						*Casing cut off 5' below surface

Describe in detail the manner in which the well was plugged, indicating where the mud fluid was placed and the method or methods used in introducing it into the hole. If cement or other plugs were used, state the character of same and depth placed, from \_\_\_\_\_ feet to \_\_\_\_\_ feet for each plug set.

Acid Engineers killed well with water and Yocum Well Servicing pulled tubing.  
Halliburton Oil Well Cementing Company pumped 150 cu. ft. Pozmix #1 cement into 5 1/2" casing, followed by 22 sacks Magcogel mud. Maximum and standing pressure 1000 psi.  
Casing cut off 5' below ground level, back filled hole.

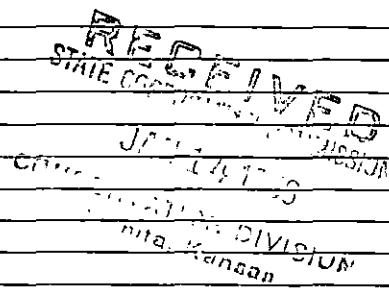

(If additional description is necessary, use BACK of this sheet)  
Name of Plugging Contractor Halliburton Oil Well Cementing Company  
Address P. O. Drawer 1431, Duncan, Oklahoma

STATE OF Kansas, COUNTY OF Grant, ss.  
W. M. Warren (employee of owner) or (owner or operator) of the above-described well, being first duly sworn on oath, says: That I have knowledge of the facts, statements, and matters herein contained and the log of the above-described well as filed and that the same are true and correct. So help me God.

(Signature) W M Warren Field Supt.  
Box 507, Ulysses, Kansas (Address)

SUBSCRIBED AND SWORN TO before me this 11 day of January, 19 56

My commission expires November 12, 1958

J. G. Cherry Notary Public.

