

STATE OF KANSAS
STATE CORPORATION COMMISSION

WELL PLUGGING RECORD

Give All Information Completely
Make Required Affidavit
Mail or Deliver Report to
Conservation Division
State Corporation Comm.
245 North Water
Wichita, KS 67202

Seward County. Sec. 34 Twp. 32S Rge. 32W E/W
Location as "NE/CNW $\frac{1}{4}$ /SW $\frac{1}{4}$ " or footage from lines
C SE SE NW

Lease Owner Orion Energy Corporation
Lease Name Irwin Well No. 1


Office Address PO Box 1578, Liberal, Kansas 67901
Character of Well (Completed as Oil, Gas or Dry Hole) Dry Hole

Date Well completed 7-8 1979
Application for plugging filed 19
Application for plugging approved 19
Plugging commenced 7-10 1979
Plugging completed 7-11 1979
Reason for abandonment of well or producing formation Dry Hole

If a producing well is abandoned, date of last production 19

Was permission obtained from the Conservation Division or its agents before plugging was commenced? yes

Name of Conservation Agent who supervised plugging of this well Bill Owens
Producing formation _____ Depth to top _____ Bottom _____ Total Depth of Well 6113'
Show depth and thickness of all water, oil and gas formations.

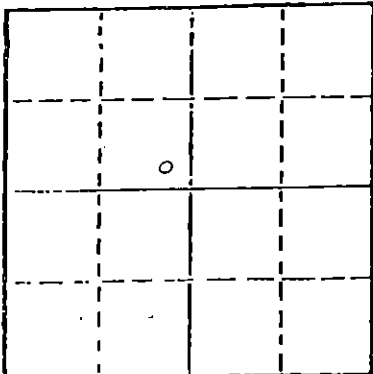

Locate well correctly on above Section Plot

OIL, GAS OR WATER RECORDS

CASING RECORD

FORMATION	CONTENT	FROM	TO	SIZE	PUT IN	PULLED OUT
				8 5/8"	1640'	none

Describe in detail the manner in which the well was plugged, indicating where the mud fluid was placed and the method or methods used in introducing it into the hold. If cement or other plugs were used, state the character of same and depth placed, from _____ feet to _____ feet for each plug set.

Plugged well as follows: 50 sacks @ 5920'-5820'
50 sacks @ 1697'-1597'
10 sacks @ 33'- 3'
5 sacks in rathole
5 sacks in mousehole


job completed @ 12:20AM, 7-11-79

(If additional description is necessary, use BACK of this sheet)

Name of Plugging Contractor Halliburton, Liberal, Kansas

STATE OF KANSAS COUNTY OF SEWARD, ss.
Ned E. Lowry (employee of owner) or (owner or operator)
of the above-described well, being first duly sworn on oath, says: That I have knowledge of the facts, statements, and matters herein contained and the log of the above-described well as filed and that the same are true and correct. So help me God.

(Signature) Ned E. Lowry, Agent
PO Box 1578, Liberal, Kansas 67901
(Address)

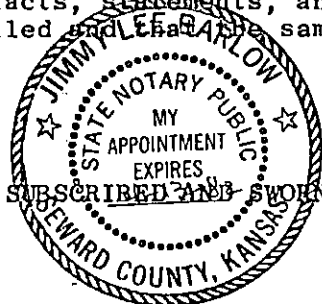

SUBSCRIBED AND SWORN TO before me this 11th day of July, 19 79

Jimmie Lee Barlow
Notary Public.

My commission expires April 13, 1982

RECEIVED
STATE CORPORATION COMMISSION

JUL 12 1979

CONSERVATION DIVISION
Wichita, Kansas