

STATE OF KANSAS
STATE CORPORATION COMMISSION


Form CP-4

Give All Information Completely
Make Required Affidavit
Mail or Deliver Report to:
Conservation Division
State Corporation Commission
P. O. Box 17027
Wichita, Kansas 67217
NORTH

WELL PLUGGING RECORD

Seward County, Sec. 34 Twp. 32S Rge. 32 (W)

Location as "NE/CNW/SW" or footage from lines NE SW NW/4
Lease Owner Petroleum Inc.
Lease Name Irwin Well No. 2
Office Address P. O. Box 1255 Liberal, KS 67901
Character of Well (completed as Oil, Gas or Dry Hole) Dry Hole
Date well completed 10/22 19 81
Application for plugging filed 11/11 19 81
Application for plugging approved 10/23 19 81
Plugging commenced 10/24 19 81
Plugging completed 10/24 19 81
Reason for abandonment of well or producing formation Dry Hole

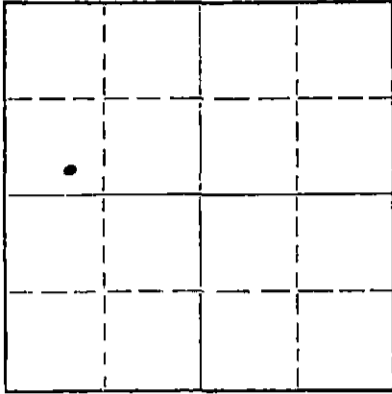

Locate well correctly on above Section Plat

If a producing well is abandoned, date of last production 19
Was permission obtained from the Conservation Division or its agents before plugging was commenced? Yes

Name of Conservation Agent who supervised plugging of this well Paul Luthi
Producing formation _____ Depth to top _____ Bottom _____ Total Depth of Well 6110 Feet
Show depth and thickness of all water, oil and gas formations.

OIL, GAS OR WATER RECORDS

CASING RECORD

FORMATION	CONTENT	FROM	TO	SIZE	PUT IN	PULLED OUT
				8 5/8	1626	None

Describe in detail the manner in which the well was plugged, indicating where the mud fluid was placed and the method or methods used in introducing it into the hole. If cement or other plugs were used, state the character of same and depth placed, from _____ feet to _____ feet for each plug set.

40 sks. 1656-1526
10 sks. 40- 3
5 sks. rathole
5 sks. mousehole
Job completed 7:15 a.m. 10/24/81

(If additional description is necessary, use BACK of this sheet)


Name of Plugging Contractor Dwell
Address Hlysses, Kansas

STATE OF Kansas, COUNTY OF Seward, ss.
Merle Evers (employee of owner) or (owner/lessee) of the above-described well, being first duly sworn on oath, says: That I have knowledge of the facts, statements, and matters herein contained and the log of the above-described well as filed and that the same are true and correct. So help me God.

(Signature) Merle Evers

11-12-81 P. O. Box 1255 Liberal, KS 67901 (Address)

SUBSCRIBED AND SWORN TO before me this 11th day of November, 1981.

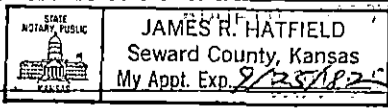

James R. Hatfield Notary Public.