


STATE OF KANSAS
STATE CORPORATION COMMISSION

Give All Information Completely
Make Required Affidavit
Mail or Deliver Report to:
Conservation Division
State Corporation Commission
212 North Market, Insurance Bldg.
Wichita, Kansas

WELL PLUGGING RECORD

Seward County, Sec. 32 Twp. 32 Rge. 32 (E) W (W)
Location as "NE/CNW/SW" or footage from lines C/NW

Lease Owner Dean A. Draper
Lease Name Wettstein Well No. 1
Office Address Garden City, Kans.
Character of Well (completed as Oil, Gas or Dry Hole) Gas
Date well completed 12 - 9 19 54
Application for plugging filed 5 - 23 19 59
Application for plugging approved 5 - 26 19 59
Plugging commenced 6 - 11 19 59
Plugging completed 6 - 14 19 59
Reason for abandonment of well or producing formation Depleted

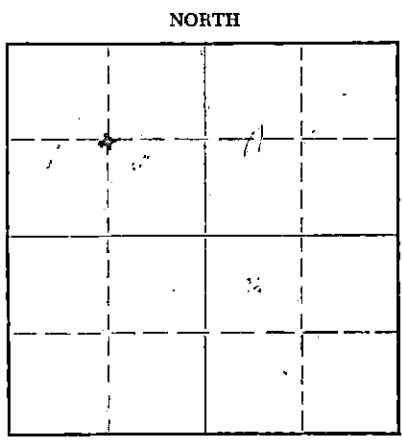

Locate well correctly on above Section Plat

If a producing well is abandoned, date of last production April 19 59
Was permission obtained from the Conservation Division or its agents before plugging was commenced? Yes

Name of Conservation Agent who supervised plugging of this well Merle Rives
Producing formation Herington-Krider Depth to top 2616 Bottom 2655 Total Depth of Well 2655 Feet
Show depth and thickness of all water, oil and gas formations.

OIL, GAS OR WATER RECORDS

CASING RECORD

FORMATION	CONTENT	FROM	TO	SIZE	PUT IN	PULLED OUT
Herington-Krider	gas	2616	2655	8 5/8 5 1/2	625' 2618'	none 1475'

Describe in detail the manner in which the well was plugged, indicating where the mud fluid was placed and the method or methods used in introducing it into the hole. If cement or other plugs were used, state the character of same and depth placed, from _____ feet to _____ feet for each plug set.

Plug back with sand from 2655' to 2600' mixed and dumped 4 sx cem from 2600' to 2568' shot pipe loose circulated gel mud (HOWCO pump truck) Pulled 8 5 1/2 csg bailed hole to 600' set 5' rock bridge, mixed and dumped 20 sx cem to 540', filled hole with mud to 35' set 5' rock bredge mix and put in 10 sx cem fill to base of cellar.

RECEIVED
STATE CORPORATION COMMISSION
JUL 22 1959
CONSERVATION DIVISION
Wichita, Kansas

(If additional description is necessary, use BACK of this sheet).
Name of Plugging Contractor Acé Pipe Pulling Co. License No. 2
Address Great Bend, Kans.

STATE OF Kansas, COUNTY OF Finney, ss.
Mr. R. W. Lange (employee of owner) or (owner or operator) of the above-described well, being first duly sworn on oath, says: That I have knowledge of the facts, statements, and matters herein contained and the log of the above-described well as filed and that the same are true and correct. So help me God.

(Signature) R. W. Lange
Box 434, Garden City, Kansas
(Address)

SUBSCRIBED AND SWORN TO before me this 21st day of July, 19 59

My commission expires Nov. 1, 60
J. J. Henning Notary Public.

PLUGGING
FILE SEC. 32 T. 32 R. 32N
BOOK PAGE 40 LINE 31