

WELL PLUGGING RECORD

Give All Information Completely
Make Required Affidavit
Mail or Deliver Report to:
Conservation Division
State Corporation Commission
211 No. Broadway
Wichita, Kansas

Seward County, Sec. 29 Twp. 32s Rge. 32w (E) (W)

Location as "NE/CNW/SW" or footage from lines C SW/4

Lease Owner Walter Kuhn Drilling Company

Lease Name Prater Well No. 1

Office Address 726 Union Center Building Wichita, Kansas

Character of Well (completed as Oil, Gas or Dry Hole) Gas

Date well completed 1-28 19 54

Application for plugging filed 4-22 19 64

Application for plugging approved 4-23 19 64


Plugging commenced 4-24 19 64

Plugging completed 4-25 19 64

Reason for abandonment of well or producing formation Produced from Hugoton Pay. in non-commercial quantities

If a producing well is abandoned, date of last production December 19 63

Was permission obtained from the Conservation Division or its agents before plugging was commenced? Yes

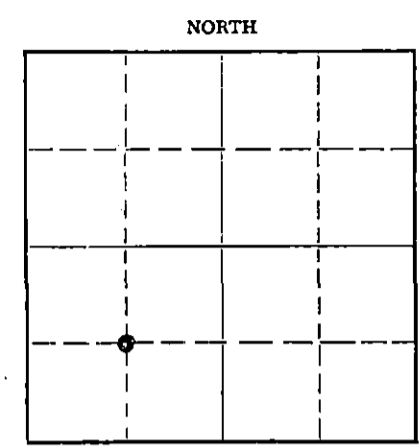

Locate well correctly on above Section Plat

Name of Conservation Agent who supervised plugging of this well High Scott

Producing formation Hugoton Depth to top 2728 Bottom 2740 Total Depth of Well 2764 Feet

Show depth and thickness of all water, oil and gas formations.

OIL, GAS OR WATER RECORDS

CASING RECORD

FORMATION	CONTENT	FROM	TO	SIZE	PUT IN	PULLED OUT
				8 5/8	565	none
				5 1/2	2734	1830
No log available.						

Describe in detail the manner in which the well was plugged, indicating where the mud fluid was placed and the method or methods used in introducing it into the hole. If cement or other plugs were used, state the character of same and depth placed, from _____ feet to _____ feet for each plug set.

Mix 35 sacks cement to plug bottom off. Stop plug at 2450 feet. Mud to 565' and pump 35 sacks of cement 565' to 465. Mud to 45' and 15 sacks cement 45' to 0'. Cut 8 5/8 off 3 feet below ground level and weld metal cap on same.

RECEIVED
STATE CORPORATION COMMISSION

APR 29 1964

CONSERVATION DIVISION
Wichita, Kansas

(If additional description is necessary, use BACK of this sheet)

Name of Plugging Contractor Sargent's Casing Pulling Service

Address Box 506 Liberal, Kansas

STATE OF Kansas, COUNTY OF Sedgwick, ss.

Walter Kuhn, Owner (employee of owner) or (owner or operator) of the above-described well, being first duly sworn on oath, says: That I have knowledge of the facts, statements, and matters herein contained and the log of the above-described well as filed and that the same are true and correct. So help me God.

(Signature) Walter Kuhn
726 Union Center, Wichita, Kansas
(Address)

SUBSCRIBED AND SWORN to before me this 28th day of April, 19 64

My commission expires May 16, 1967

Lucille Kerr
Lucille Kerr
Notary Public.