


STATE OF KANSAS
STATE CORPORATION COMMISSION

Give All Information Completely
Make Required Affidavit
Mail or Deliver Report to:
Conservation Division
State Corporation Commission
212 No. Market
Wichita, Kansas

WELL PLUGGING RECORD

NORTH

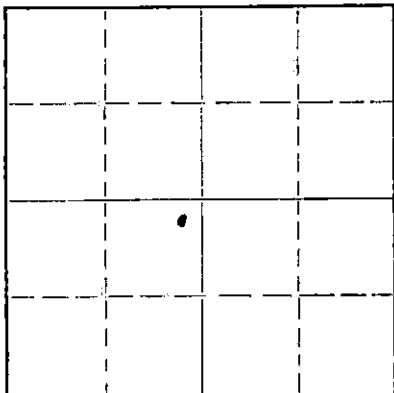

Locate well correctly on above Section Plat

Seward County. Sec. 25 Twp. 32S Rge. (E) 32 (W)
Location as "NE/CNWKSWK" or footage from lines C NE NE SW
Lease Owner: Anadarko Production Company
Lease Name: Birney "A" Well No. 1
Office Address: Box 351, Liberal, Kansas 67901
Character of Well (completed as Oil, Gas or Dry Hole) Dry Hole
Date well completed Dec. 13 19 69
Application for plugging filed 19
Application for plugging approved 19
Plugging commenced Dec. 13 19 69
Plugging completed Dec. 13 19 69
Reason for abandonment of well or producing formation

If a producing well is abandoned, date of last production 19
Was permission obtained from the Conservation Division or its agents before plugging was commenced? Yes

Name of Conservation Agent who supervised plugging of this well Edgar J. Eves
Producing formation Depth to top Bottom Total Depth of Well 6160 Feet
Show depth and thickness of all water, oil and gas formations.

OIL, GAS OR WATER RECORDS

CASING RECORD

FORMATION	CONTENT	FROM	TO	RECEIVED BY	PUT IN	PULLED OUT
				STATE CORPORATION COMMISSION	DEC 23 1969	
				CONSERVATION DIVISION	Wichita, Kansas	

Describe in detail the manner in which the well was plugged, indicating where the mud fluid was placed and the method or methods used in introducing it into the hole. If cement or other plugs were used, state the character of same and depth placed, from feet to feet for each plug set.

Filled hole with mud to 1600'
Spotted 45 sacks cement 1600' to 1500'
Filled hole with mud to 45'
Spotted 20 sacks cement from 45' to surface.
Plugging completed @ 6:30 A.M. 12-13-69


(If additional description is necessary, use BACK of this sheet)

Name of Plugging Contractor: Stickle Drilling Company
Address: Wichita, Kansas

STATE OF Kansas, COUNTY OF Seward, ss.
I, WILLIAM V. K. Downey (employee of owner) or (owner or operator) of the above-described well, being first duly sworn on oath, says: That I have knowledge of the facts, statements, and matters herein contained and the log of the above-described well as filed and that the same are true and correct. So help me God.

(Signature) [Signature]
Box 351, Liberal, Kansas 67901 (Address)

Subscribed and sworn to before me this 19th day of December, 19 69

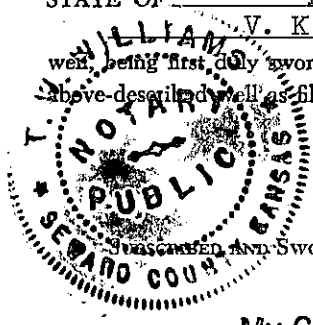

My commission expires April 28, 1971 Notary Public.

DRILLER'S LOG

WELL NAME: Birney "A" No. 1 ; COMPANY OPERATING: Anadarko Production Company
 ADDRESS of COMPANY: Box 351 Liberal, Kansas 67901
 WELL LOCATION: 1/4 NE 1/4 SW 1/4,
2310 ft. North of South line,
2310 ft. East of West line: Sec. 25, Twp. 32S, Rge. 32W, Seward County, Kansas
 DRILLING STARTED 11-27, 19 69; DRILLING COMPLETED 12-10, 19 69
 WELL COMPLETED 12-13, 19 69; WELL CONNECTED _____, 19 _____
 ELEVATION: 2785.6 ft. Ground Level; CHARACTER OF WELL (Oil, Gas, or Dry Hole) Dry Hole

OIL OR GAS SANDS OR ZONES - PERFORATIONS - ACIDIZING AND FRACTURING INFORMATION					
Name	From	To	No. of Shots	Gallons Used	Kind Used

RECEIVED
 STATE CORPORATION COMMISSION
 DEC 23 1969
 CONSERVATION DIVISION
 Wichita, Kansas

CASING RECORD

Size	Amount Set	Sacks of Cement	Amount Pulled
8 5/8"	1633'	800	None

FORMATION RECORD

Formation	Top	Bottom	Formation	Top	Bottom
Surface Sand & Clay	0'	50'	Lime	4364'	4452'
Sand & Clay	50'	960'	Lime & Shale	4452'	4590'
Sand & Red Bed	960'	1585'	Lime	4590'	5110'
Shale & Anhydrite	1585'	1634'	Lime & Shale	5110'	5495'
Anhydrite & Red Bed	1634'	1903'	Shale & Lime	5495'	5571'
Red Bed & Shale	1903'	2280'	Lime & Shale	5571'	5745'
Shale & Anhydrite	2280'	2525'	Lime	5745'	6160'
Anhydrite & Dolomite	2525'	2765'	Total Depth	6160'	
Dolomite & Shale	2765'	3008'			
Lime	3008'	3434'			
Lime & Shale	3434'	3655'			
Lime	3655'	4239'			
Lime & Shale	4239'	4364'			

RESULTS of INITIAL PRODUCTION TEST: _____

