


STATE OF KANSAS
STATE CORPORATION COMMISSION

WELL PLUGGING RECORD

Give All Information Completely
Make Required Affidavit
Mail or Deliver Report to
Conservation Division
State Corporation Comm.
245 North Water
Wichita, KS 67202

Seward County, Sec. 22 Twp. 32 Rge. 32 E/W
Location as "NE/CNW/SW" or footage from lines
660 FEL & 1320 FNL

Lease Owner Crown Production Co. Inc.
Lease Name Reiss Well No. 1
Office Address 13531 N. Central Expressway, Dallas, TX.
Character of Well (Completed as Oil, Gas or Dry Hole)

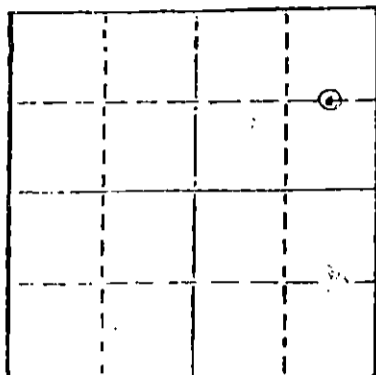

Locate well correctly on above
Section Plot

Gas
Date Well completed February 25 1980
Application for plugging filed 12-18-80 19
Application for plugging approved 12-19-80 19
Plugging commenced 12-19-80 19
Plugging completed 12-22-80 19
Reason for abandonment of well or producing formation
Non Commercial Value
If a producing well is abandoned, date of last production
None 19

Was permission obtained from the Conservation Division or
its agents before plugging was commenced? yes

Name of Conservation Agent who supervised plugging of this well Mr. Thomas
Producing formation Hugoton Depth to top 2680 Bottom 2717 Total Depth of Well 4500
Show depth and thickness of all water, oil and gas formations.

OIL, GAS OR WATER RECORDS

CASING RECORD

FORMATION	CONTENT	FROM	TO	SIZE	PUT IN	PULLED OUT
Surface				8 5/8"	1721'	0
Production				4 1/2"	4497'	2060'

Describe in detail the manner in which the well was plugged, indicating where the mud fluid
was placed and the method or methods used in introducing it into the hold. If cement or other
plugs were used, state the character of same and depth placed, from _____ feet to
_____ feet for each plug set.

Pumped 1 sk. hulls & 25 sks. cement to 2400' - Pressured to 750 lbs.
Displaced to 1750'
Spotted 35 sks cement 750' to 1650'
Displaced to 800'
Spotted 25 sks. cement 800' to 725'
Put bridge & 10 sks. cement 40' to 0'
Cut off 8 5/8" - 3' below ground level & weld plate on 8 5/8"

(If additional description is necessary, use BACK of this sheet)

Name of Plugging Contractor Midwest Casing Pulling Service,
Permit # 766

STATE OF Kansas COUNTY OF Haskell, ss.
I, Edgar J. Eves (employee of owner) or (owner or operator)
of the above-described well, being first duly sworn on oath, says: That I have knowledge of
the facts, statements, and matters herein contained and the log of the above-described well
as filed and that the same are true and correct. So help me God.

(Signature)

Edgar J. Eves
Box F, Sublette, Ks. 67877
(Address)

SUBSCRIBED AND SWORN TO before me this 26th day of Dec., 1980

Sandra L. Eves
Notary Public.

My commission expires 12-6-84

RECEIVED
STATE CORPORATION COMMISSION

DEC 30 1980

CONSERVATION DIVISION
Wichita, Kansas

