


15-175-00238-0000

STATE OF KANSAS
ST. CORPORATION COMMISSION
Give Information Completely
Make Required Affidavit
Mail or Deliver Report to:
Conservation Division
State Corporation Commission
800 Bittig Building
Wichita, Kansas

WELL PLUGGING RECORD

NORTH

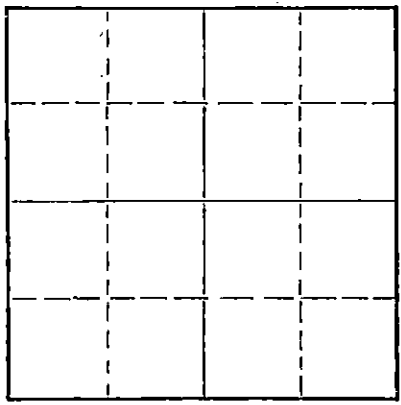

Locate well correctly on above Section Plat

Seward County. Sec. 16 Twp. 32 Rge. (E) 32 (W)
Location as "NE/CNW/SE/SW" or footage from lines 150'S & 150'W of Center
Lease Owner Draper Motors Corp.
Lease Name Lambert Well No. 1
Office Address 2344 Woodward Ave., Royal Oak, Michigan
Character of Well (completed as Oil, Gas or Dry Hole) Dry Hole
Date well completed January 2, 1955 19
Application for plugging filed January 11, 1955 19
Application for plugging approved January 19, 1955 19
Plugging commenced January 17, 1955 19
Plugging completed January 18, 1955 19
Reason for abandonment of well or producing formation Dry Hole

If a producing well is abandoned, date of last production _____ 19
Was permission obtained from the Conservation Division or its agents before plugging was commenced? Yes Orally

Name of Conservation Agent who supervised plugging of this well R. J. Phillippe
Producing formation Hugoton Series Depth to top 2614 Bottom 2745 Total Depth of Well 2745 Feet
Show depth and thickness of all water, oil and gas formations.

OIL, GAS OR WATER RECORDS

CASING RECORD

FORMATION	CONTENT	FROM	TO	SIZE	PUT IN	PULLED OUT
<u>Ogalalla</u>	<u>Water</u>	<u>0</u>	<u>480</u>	<u>8 5/8</u>	<u>574</u>	<u>None</u>
<u>Permian</u>	<u>Shale & Lime</u>	<u>480</u>	<u>2745</u>	<u>5 1/2</u>	<u>2614</u>	<u>1176</u>

Describe in detail the manner in which the well was plugged, indicating where the mud fluid was placed and the method or methods used in introducing it into the hole. If cement or other plugs were used, state the character of same and depth placed, from _____ feet to _____ feet for each plug set.

Filled hole with heavy mud to 570. Set Halliburton bridging plug at 570. Plugged with cement from 570 to 416 - 50 sacks. Filled with mud 416 to 35. Plugged with 10 sacks of cement from 35 to 4' below surface. Cut off 8 5/8" 4' under surface and welded a steel plate on top.

(If additional description is necessary, use BACK of this sheet)

Name of Plugging Contractor Gibson Machine and Tool Co. Halliburton Oil Well Cementing Co.
Address Box 1111, Borger, Texas

STATE OF KANSAS, COUNTY OF FINNEY, ss.
R. W. Lange (employee of owner) or (~~owner~~) of the above-described well, being first duly sworn on oath, says: That I have knowledge of the facts, statements, and matters herein contained and the log of the above-described well as filed and that the same are true and correct. So help me God.

(Signature) [Signature]
Box 434, Garden City, Kansas (Address)

SUBSCRIBED AND SWORN TO before me this 9 day of February 1955

My commission expires January 28, 1958

[Signature]
Notary Public.
STATE CORP. COMMISSION

PLUGGING
FILE SEC 16 T 32 R 32W
BOOK PAGE 91 LINE 36

FEB 1 1955
CONSERVATION DIVISION
Wichita, Kansas

R. W. LANGE

DRAPER MOTORS CORPORATION

Lambert #1

Section 16-32-32

Seward County, Kansas

Drilling Log

0 - 115	Clay and Sand
115 - 215	Sandy Shale and Shells
215 - 400	Sandy Clay
400 - 465	Clay and Shale
465 - 530	Red Bed and Sand
530 - 583	Red Bed and Shells
583 - 1710	Shale and Shells
1710 - 1845	Anhydrite, Shale and Shells
1845 - 1875	Anhydrite
1875 - 1920	Shale, Shells, and Anhydrite
1920 - 2635	Shale and Lime
2635 - 2671	Lime
2671 - 2685	Hard Lime
2685 - 2692	Broken Lime and Shale
2692 - 2745	Lime

Drillers: L. E. Putter, H. Riggs, Frank Foster, Felix Littlejohn, C. L. Hinds, Norman Hinds, J. E. Tillery, and J. Richardson.

PLUGGING
 FILE SEC 16-32-R-320
 BOOK PAGE 91 LINE 36

RECEIVED
STATE GEOLOGICAL COMMISSION

FEB 10 1955

STATE GEOLOGICAL COMMISSION
TOPEKA, KANSAS