


15-175-20004-0000 *SR*

STATE OF KANSAS  
STATE CORPORATION COMMISSION

WELL PLUGGING RECORD

Give All Information Completely  
Make Required Affidavit  
Mail or Deliver Report to:  
Conservation Division  
State Corporation Commission  
211 No. Broadway  
Wichita, Kansas

Seward County. Sec. 14 Twp. 32S Rge. 32 (E) W (W)  
Location as "NE/CNW%SW%" or footage from lines 1980' SNL & 2010' WEL  
Lease Owner GETTY OIL COMPANY  
Lease Name F. E. DUFFIELD Well No. 1  
Office Address P. O. Box 752, Drumright, Oklahoma 74030  
Character of Well (completed as Oil, Gas or Dry Hole) Dry Hole  
Date well completed October 19 1967  
Application for plugging filed October 6 1967  
Application for plugging approved October 9 1967  
Plugging commenced October 18 1967  
Plugging completed October 19 1967  
Reason for abandonment of well or producing formation Dry Hole

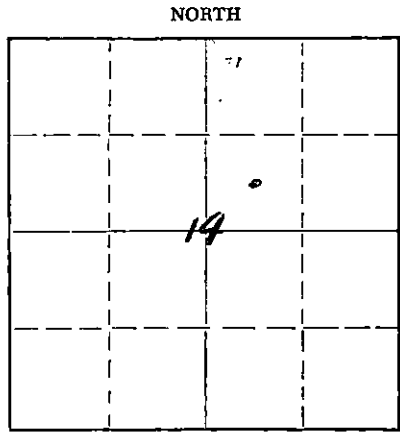

Locate well correctly on above Section Plat

If a producing well is abandoned, date of last production - 19 -  
Was permission obtained from the Conservation Division or its agents before plugging was commenced? Yes

Name of Conservation Agent who supervised plugging of this well E. Eves  
Producing formation - Depth to top - Bottom - Total Depth of Well 7280 Feet  
Show depth and thickness of all water, oil and gas formations.

OIL, GAS OR WATER RECORDS				CASING RECORD		
FORMATION	CONTENT	FROM	TO	SIZE	PUT IN	PULLED OUT
				8 5/8"	2203	0
				4 1/2"	6200	2201

Describe in detail the manner in which the well was plugged, indicating where the mud fluid was placed and the method or methods used in introducing it into the hole. If cement or other plugs were used, state the character of same and depth placed, from - feet to - feet for each plug set.

Pumped 4,280 barrels of mud and water into well at 8 bbls. per min. at 250 psi. Squeezed perms. from 2726' - 2732' with 25 sacks of Pozmix. Top of cement at 2480'. Mixed 5 sacks of gel at 700', pumped 40 sacks of cement at 600' to 500'. Put 10 sacks of cement at 30' to 0'. Welded steel plate on top of surface pipe 3 feet below ground level.

RECEIVED  
STATE CORPORATION COMMISSION  
OCT 27 1967  
CONSERVATION DIVISION  
WICHITA, KANSAS

(If additional description is necessary, use BACK of this sheet)  
Name of Plugging Contractor Sargent's Casing Pulling Service  
Address P.O. Box 506, Liberal Kansas 67901

STATE OF Oklahoma, COUNTY OF Creek, ss.  
W. H. McPail (employee of owner) or (owner or operator) of the above-described well, being first duly sworn on oath, says: That I have knowledge of the facts, statements, and matters herein contained and the log of the above-described well as filed and that the same are true and correct. So help me God.

(Signature) W. H. McPail Area Supt.  
P. O. Box 752, Drumright, Oklahoma 74030  
(Address)

SUBSCRIBED AND SWORN TO before me this 25 th day of October, 1967  
P. W. J. [Signature]  
Notary Public.

My commission expires 11-23-69

KCC  
Eves  
Boone  
Shackelford  
File

1980' SNL & 2010' WEL  
SECTION 14-32S-32W  
SEWARD COUNTY, KANSAS

F. E. DUFIELD WELL NO. 1

CONTRACTOR: RINE DRILLING COMPANY, INC.

STARTED: MAY 16, 1967

COMPLETED: JUNE 8, 1967

L O G

Clay & Sand	0'	-	257'
Sand & Red Bed	257'	-	803'
Red Bed, Gypsum, & Sand	803'	-	1500'
Shale & Anhydrite	1500'	-	1809'
Shale & Anhydrite	1809'	-	2024'
Red Bed	2024'	-	2203'

Shale	2203'	-	2490'
Shale & Anhydrite	2490'	-	2744'
Lime	2744'	-	2762'
Shale	2762'	-	2848'
Shale & Soft Lime	2848'	-	3082'
Soft Lime Streaks	3082'	-	3312'
Lime	3312'	-	3489'
Lime & Chalk Streaks	3489'	-	3768'
Shale & Lime	3768'	-	3967'
Lime	3967'	-	4061'
Lime Streaks	4061'	-	4066'
Lime	4066'	-	4524'
Lime Streaks	4524'	-	4616'
Lime	4616'	-	4672'
Lime Streaks	4672'	-	4803'
Lime	4803'	-	5047'
Lime & Shale	5047'	-	5170'
Lime Streaks & Shale	5170'	-	5252'
Lime	5252'	-	5474'
Lime Streaks & Shale	5474'	-	5507'
Lime	5507'	-	5603'
Lime Streaks	5603'	-	5673'
Lime	5673'	-	5863'
Lime Streaks	5863'	-	5922'
Lime - Chert	5922'	-	5971'
Lime	5971'	-	6041'
Lime Streaks	6041'	-	6125'
Lime	6125'	-	6347'
Lime Streaks	6347'	-	6430'
Lime	6430'	-	6580'
Lime Streaks	6580'	-	6770'
Lime	6770'	-	6840'
Lime Streaks	6840'	-	6993'
Lime	6993'	-	7126'
Lime Streaks	7126'	-	7252'
Lime	7252'	-	7280'

Totco - 1/4° @ 500'

Totco - 1/2° @ 1000'

Totco - 1/2° @ 1525'

Totco - 1° @ 1924'

Ran 71 jts. 8 5/8 Csg. to 2203'. Cem.  
w/850 sx. poz. mix w/6% gel & 150 sx.  
reg. 3% c.c.

Totco - 3/4° @ 2762'

Totco - 1° @ 4250'

Totco - 1 1/2° @ 4882'

RECEIVED  
OCT 18 1967  
CONSERVATION DIVISION  
Wichita, Kansas

Totco - 1 1/4° @ 6489'

Totco - 1° @ 7070'

Ran 195 jts. 4 1/2" 11-1# J-55 Csg.  
to 6202', cem. w/500 sx. lightwater  
w/ 1/4 of 1% Flo-Seal per sk. & 170  
sk. lightwater w/ 1/4 of 1% Flo-Seal  
per sk.

1980/  
1980' SNL & 2010' WEL  
SECTION 14-32S-32W  
SEWARD COUNTY, KANSAS


F. E. DUFIELD WELL NO. 1 - Page 2

STATE OF KANSAS     )  
COUNTY OF SEDGWICK)           ss

I, R. M. Green, do hereby certify that the above is a true and accurate log of the F. E. Dufield Well no. 1, located 1980' SNL & 2010' WEL of Section 14-32S-32W, Seward County, Kansas.

  
\_\_\_\_\_  
R. M. Green, Secretary-Treasurer

Subscribed and sworn to before me this 12th day of June, 1967.

  
\_\_\_\_\_  
Sam R. Clift, Notary Public

My Commission Expires: 9/4/68.

RECEIVED  
STATE CORPORATION COMMISSION  
JUN 18 1967  
CONSERVATION DIVISION  
Wichita, Kansas