

15-175-20226-0000

STATE OF KANSAS
STATE CORPORATION COMMISSION


Form CP-4

Give All Information Completely
Make Required Affidavit
Mail or Deliver Report to:
Conservation Division
State Corporation Commission
P. O. Box 17027
Wichita, Kansas 67217
NORTH

WELL PLUGGING RECORD

Seward County. Sec. 14 Twp. 32 Rge. 32 (W)
Location as "NE/CNW/SW" or footage from lines 660' FWL & 1980' ESL
Lease Owner Gas Producing Enterprises, Inc.
Lease Name Harney Well No. 1
Office Address 415 W. 8th St.-Suite 300, Amarillo, Texas 79101
Character of Well (completed as Oil, Gas or Dry Hole) Dry Hole
Date well completed 6/14/ 19 74
Application for plugging filed 9/6/ 19 74
Application for plugging approved 9/12/ 19 74
Plugging commenced 9/27/ 19 74
Plugging completed 9/30/ 19 74
Reason for abandonment of well or producing formation Dry Hole

If a producing well is abandoned, date of last production Never Produced 19
Was permission obtained from the Conservation Division or its agents before plugging was commenced? Yes

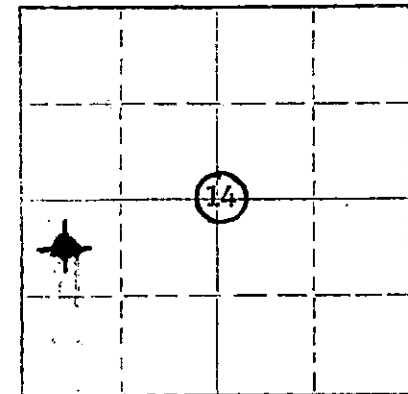

Locate well correctly on above Section Plat

Name of Conservation Agent who supervised plugging of this well Mr. Clarence F. Thomas, Jr.
Producing formation Never Produced Depth to top Bottom Total Depth of Well 6040 Feet
Show depth and thickness of all water, oil and gas formations.

OIL, GAS OR WATER RECORDS

CASING RECORD

FORMATION	CONTENT	FROM	TO	SIZE	PUT IN	PULLED OUT
Herrington	Salt Water	2660'	2698'	8-5/8"	1601'	-
Lansing	Salt Water	4366'	4873'	4-1/2"	5718'	3185
Marmaton	Salt Water	4994'	5032'			
Morrow	Salt Water	5504'	5614'			
Chester	Salt Water	5627'	5722'			

Describe in detail the manner in which the well was plugged, indicating where the mud fluid was placed and the method or methods used in introducing it into the hole. If cement or other plugs were used, state the character of same and depth placed, from feet to feet for each plug set.

Pumped 15 sx cmt down 4-1/2" csg from 5607 to 5400'. Shot 4-1/2" csg off @ 3185'. Spotted 35 sx cmt from 900' to 800' & 15 sx cmt from 35' to 0' through 4-1/2" csg as it was being pulled.

RECEIVED
STATE CORPORATION COMMISSION

CON: RECEIVED
STATE CORPORATION COMMISSION

OCT 16 1974

CONSERVATION DIVISION
Wichita, Kansas

(If additional description is necessary, use BACK of this sheet)

Name of Plugging Contractor Bob Sargent
Address Liberal, Kansas

STATE OF TEXAS COUNTY OF POTTER, ss.

(employee of owner) or (notary public) of the above-described well, being first duly sworn on oath, says: That I have knowledge of the facts, statements, and matters herein contained and the log of the above-described well as filed and that the same are true and correct. So help me God.

(Signature) W.E. Rawlings, Sr. Engineer
415 W. 8th St.-Suite 300, Amarillo, Texas 79101
(Address)

SUBSCRIBED AND SWORN TO before me this 14th day of October, 19 74

My commission expires June 1, 1975

Patricia Mann
Notary Public.