

STATE OF KANSAS
STATE CORPORATION COMMISSION


WELL PLUGGING RECORD

Give All Information Completely
Make Required Affidavit
Mail or Deliver Report to:
Conservation Division
State Corporation Commission
800 Bittling Building
Wichita, Kansas

Seward County, Sec. 8 Twp. 32 Rge. 32 (X) W (W)

Location as "NE/CNW/SW" or footage from lines C of NE/4
Lease Owner Prince Brothers Drilling Co.
Lease Name Collingwood B Well No. 1
Office Address Box 992, Electra, Texas
Character of Well (completed as Oil, Gas or Dry Hole) Dry Hole
Date well completed January 20, 19 55
Application for plugging filed 19
Application for plugging approved April 7, 19 55
Plugging commenced July 14, 19 55
Plugging completed July 16, 19 55
Reason for abandonment of well or producing formation Dry Hole

NORTH

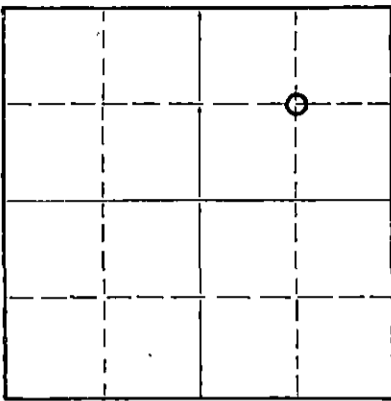

Locate well correctly on above Section Plat

If a producing well is abandoned, date of last production No production 19
Was permission obtained from the Conservation Division or its agents before plugging was commenced? Yes

Name of Conservation Agent who supervised plugging of this well R. J. Phillippe
Producing formation Krider Depth to top 2650 Bottom 2685 Total Depth of Well 2685 Feet
Show depth and thickness of all water, oil and gas formations.

OIL, GAS OR WATER RECORDS

CASING RECORD

FORMATION	CONTENT	FROM	TO	SIZE	PUT IN	PULLED OUT
Ogalalla	Water	0	465	8 5/8	542	None
Krider	Salt Water	2650	2685	5 1/2	2684	1497

Describe in detail the manner in which the well was plugged, indicating where the mud fluid was placed and the method or methods used in introducing it into the hole. If cement or other plugs were used, state the character of same and depth placed, from _____ feet to _____ feet for each plug set.

Pumped 150 sacks of cement through perforations 2650 to 2684
Top of plug - 2556. Mudded up. 540 to 2556
Rock bridge 530 to 540
Dumped 10 sacks of cement 495 to 530
Baled hole dry. Tested for water 2 hours. No water entry.
Dumped 10 sacks of cement 460 to 495
Mudded up 40 to 460
Rock bridge 35 to 40
Dumped 10 sacks of cement 2 to 35
Cut off 8 5/8" 4' below surface.

RECEIVED
STATE CORPORATION COMMISSION
JULY 1958
CONSERVATION DIVISION
Wichita, Kansas

(If additional description is necessary, use BACK of this sheet)

Name of Plugging Contractor Arnett Well Plugging
Address Hoisington, Kansas

STATE OF KANSAS, COUNTY OF FINNEY, ss.
R. W. Lange (employee of owner) or (owner or operator) of the above-described well, being first duly sworn on oath, says: That I have knowledge of the facts, statements, and matters herein contained and the log of the above-described well as filed and that the same are true and correct. So help me God.

(Signature) R. W. Lange
Box 434, Garden City, Kansas
(Address)

SUBSCRIBED AND SWORN to before me this 27th day of July 1955
Georgia C. Brown
Notary Public.

My commission expires January 28, 1958

PLUGGING
FILE SEC. 8 T. 32 R. 32 W.
BOOK PAGE 109 LINE 33

Sec 8-32-32W

CNE/4

COLLINGWOOD "B" NO. 1

Buy

Clay and sand	0	88
Sand	88	465
Red bed	465	526
Red bed & anhydrite	526	806
Shale & gyp shells	806	930
Shale	930	1065
Gyp and shale	1065	1180
Salt & shale	1180	1428
Shale & anhydrite	1428	2410
Anhydrite	2410	2429
Anhydrite & shale	2429	2514
Anhydrite & gyp	2514	2647
Dolomite, sand & shale	2647	2692