

STATE OF KANSAS
STATE CORPORATION COMMISSION
CONSERVATION DIVISION
245 North Water
WICHITA, KANSAS. 67202

Rev. 6-3-74
FORM CP-1

WELL PLUGGING APPLICATION FORM
File One Copy

API Number '15 - 095 - 20,561-0000 (of this well)
Lease Owner Texas Oil & Gas Corp.
Address 200 W. Douglas, Suite 300 Wichita, KS 67202
Lease (Farm Name) MESSINGER Well No. 1
Well Location 1320' FSL & 1320' FEL Sec. 7 Twp. 30S Rge. (E) 6W (W)
County Kingman Total Depth 4126' Field Name Messenger
Oil Well Gas Well X Input Well SWD Well Rotary D & A
Well Log attached with this application as required Attached
Date and hour plugging is desired to begin As soon as possible

PLUGGING OF THIS WELL WILL BE DONE IN ACCORDANCE WITH K.S.A. 55-128 OF THE RULES AND REGULATIONS OF THE STATE CORPORATION COMMISSION.

Name of company representative authorized to be in charge of plugging operations:
Rich Hamm Address P.O. Box 329 Medicine Lodge, KS

Plugging Contractor Clarke Oilfield Services License No. 853
Address 107 W. Fowler, Medicine Lodge, KS 67104

Invoice covering assessment for plugging this well should be sent to
Name Texas Oil & Gas Corp.
Address 200 W. Douglas, Suite 300, Wichita, KS

RECEIVED
STATE CORPORATION COMMISSION
APR 21 1980
CONSERVATION DIVISION
Wichita, Kansas

and payment will be guaranteed by applicant or acting agent.

Signed: Kenton Hupp
Applicant or Acting Agent
Kenton Hupp, Engineer
Date: 4-17-80


WELLBORE DIAGRAM - KANSAS DISTRICT - TXO

WELL MESSENGER #1 LOCATION SEC 7-30S-6W Kingman Co

GL 1401 KB 1409

API UNIT Amer 114 SL 54" SPM 8⁸/₁₂ PMP 2 x 1 1/2 x 12
C.96 Run 5-30-79

REMARKS ACIDIZE w/ 250 qds SMDD w/ alcohol

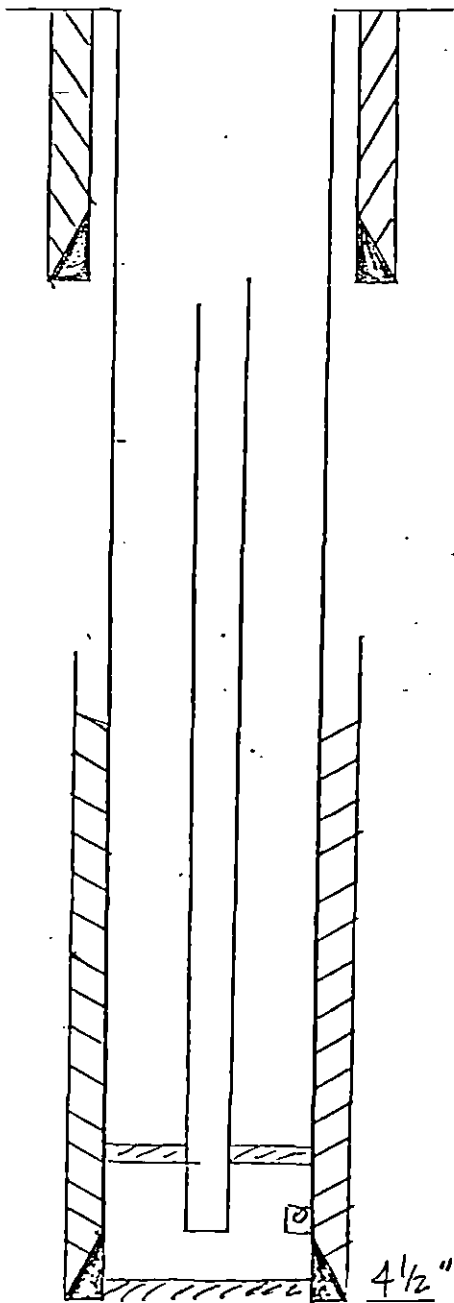

8⁵/₈" CSA 258' CMT w/ 250 SX

CMT TOP @ 3370'

tbq 2³/₈ 127 lbs @ 4094

SN @ 4074, tbq Anchor 408

PERF 4079-82

4 1/2" CSA 4125' CMT w/ 175 SX

PBD 4106'

RECEIVED
STATE CORPORATION COMMISSION

APR 21 1980

CONSERVATION DIVISION
Wichita, Kansas

State of Kansas



JOHN CARLIN
R. C. LOUX
JANE T. ROY
WILLIAM G. GRAY

Governor
Chairman
Commissioner
Commissioner

Carol J. Larson, Executive Secretary

State Corporation Commission

CONSERVATION DIVISION

(Oil, Gas and Water)
245 North Water
WICHITA, KANSAS 67202

April 21, 1980

WELL PLUGGING AUTHORITY

Messenger Well No. 1
C SE, Sec. 7-30S-6W
Kingman County
4126'
Clarke Oilfield Services


Texas Oil & Gas Corporation
200 W. Douglas, Suite 300
Wichita, KS 67202

Gentlemen:

This is your authority to plug the above subject well in accordance with the Rules and Regulations of the State Corporation Commission.

This authority is void after ninety (90) day from the above date.

Yours very truly,

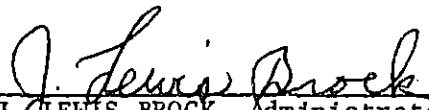
J. LEWIS BROCK, Administrator

Mr. William T. Owen, Box 369, Pratt, KS 67124

is hereby assigned to supervise the plugging of the above named well