

WELL PLUGGING RECORD

Give All Information Completely
Make Required Affidavit
Mail or Deliver Report to:
Conservation Division
State Corporation Commission
800 Biting Building
Wichita, Kansas

Morton

County. Sec. 24 Twp. 31 Rge. (E) 42 (W)

Location as "NE/CNW/SW" or footage from lines C NE/4

Lease Owner Colorado Oil & Gas Corporation

Lease Name Hayward Well No. 1-24

Office Address P. O. Box 999, Liberal, Kansas

Character of Well (completed as Oil, Gas or Dry Hole) Dry Hole

Date well completed April 28 1957

Application for plugging filed April 29 1957

Application for plugging approved April 29 1957


Plugging commenced April 29 1957

Plugging completed April 29 1957

Reason for abandonment of well or producing formation Dry - No commercial production.

If a producing well is abandoned, date of last production 19

Was permission obtained from the Conservation Division or its agents before plugging was commenced? Yes

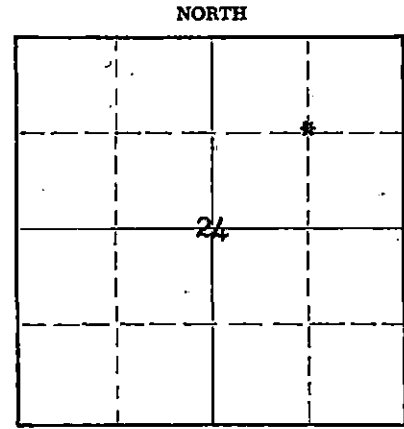

Locate well correctly on above Section Plat

Name of Conservation Agent who supervised plugging of this well M. A. Rives

Producing formation None Depth to top Bottom Total Depth of Well 5381' Feet

Show depth and thickness of all water, oil and gas formations.

OIL, GAS OR WATER RECORDS

CASING RECORD

FORMATION	CONTENT	FROM	TO	SIZE	PUT IN	PULLED OUT
None				8-5/8" 24#		None

Describe in detail the manner in which the well was plugged, indicating where the mud fluid was placed and the method or methods used in introducing it into the hole. If cement or other plugs were used, state the character of same and depth placed, from feet to feet for each plug set.

Mud from 5381' - 5290'
Cement 5290' - 5225'
Mud 5225' - 3580'
Cement 3580' - 3430'
Mud 3430' - 600'
Composition 600'
Cement to 500'
Mud to 35'
Composition Plug at 35'
Cement to bottom of cellar

(If additional description is necessary, use BACK of this sheet)

Name of Plugging Contractor Musgrove Petroleum Co. (Rotary Contractor)
Address Wichita, Kansas

STATE OF Kansas, COUNTY OF Seward, ss.
A. J. Smith (employee of owner) or (owner/operator) of the above-described well, being first duly sworn on oath, says: That I have knowledge of the facts, statements, and matters herein contained and the log of the above-described well as filed and that the same are true and correct. So help me God.

(Signature) [Signature]

P. O. Box 999, Liberal, Kansas
(Address)

SUBSCRIBED AND SWORN to before me this 29th day of April, 19 57

William B. Claunch
Notary Public

My commission expires 11-1-58

CC: Mr. J. R. Coleman
Mr. M. A. Rives
File

PLUGGING
FILE SEC. 24 T. 31 R. 42W
BOOK PAGE 9 LINE 20

