


15-129-16173-0000

WELL PLUGGING RECORD

Give All Information Completely  
Make Required Affidavit  
Mail or Deliver Report to:  
Conservation Division  
State Corporation Commission  
211 No. Broadway  
Wichita, Kansas

Morton County, Sec. 29 Twp. 31 Rge. 42 (X) (W)  
C NE

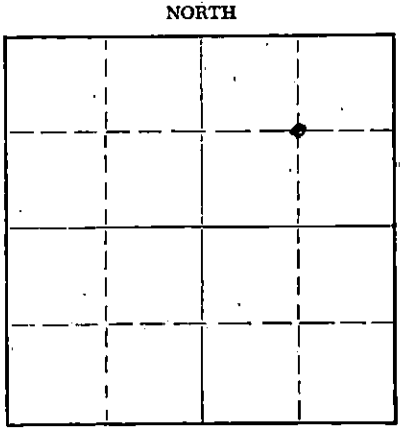

Locate well correctly on above Section Plat

Location as "NE/CNW/SW" or footage from lines  
Lease Owner Thomas & Brewer  
Lease Name Bitner Well No. 1  
Office Address Box 1177, Liberal, Kansas  
Character of Well (completed as Oil, Gas or Dry Hole) Dry Hole  
Date well completed 6-26 19 66  
Application for plugging filed 6-28 19 66  
Application for plugging approved          19           
Plugging commenced 6-27 19 66  
Plugging completed 6-27 19 66  
Reason for abandonment of well or producing formation Dry

If a producing well is abandoned, date of last production          19           
Was permission obtained from the Conservation Division or its agents before plugging was commenced? Yes

Name of Conservation Agent who supervised plugging of this well Edgar J. Eves  
Producing formation Morrow Depth to top 4604 Bottom          Total Depth of Well 5118 Feet  
Show depth and thickness of all water, oil and gas formations.

OIL, GAS OR WATER RECORDS

CASING RECORD

FORMATION	CONTENT	FROM	TO	SIZE	PUT IN	PULLED OUT
Surface sands	Fresh water	60	70	8 5/8	1433	None

Describe in detail the manner in which the well was plugged, indicating where the mud fluid was placed and the method or methods used in introducing it into the hole. If cement or other plugs were used, state the character of same and depth placed, from          feet to          feet for each plug set.

Mud to 700' and pump 35 sx cement.  
Mud to 45' and pump 15 sx cement.

RECEIVED  
STATE CORPORATION COMMISSION  
JUN 29 1966  
CONSERVATION DIVISION  
WICHITA, KANSAS

(If additional description is necessary, use BACK of this sheet)  
Name of Plugging Contractor Mahoney Drilling Company, Inc.  
Address Box 1257, Liberal, Kansas

STATE OF Kansas COUNTY OF Seward, ss.

Delvin P. Luck (employee of owner) or (owner or operator) of the above-described well, being first duly sworn on oath, says: That I have knowledge of the facts, statements, and matters herein contained and the log of the above-described well as filed and that the same are true and correct. So help me God.

(Signature) Delvin P. Luck  
Box 1177, Liberal, Kansas  
(Address)

SUBSCRIBED AND SWORN TO before me this 28 day of June, 19 66

My commission expires 4-8-68 Lila J. Brewer Notary Public.

Thomas & Brewer

15-129-10173-0000

Bitner # 1  
Sec. 29, T31, R42  
Morton County, Kansas

Set 24# 8-5/8" Csg. @1433'KB  
700 Sx Cement Circulated.  
Set 35 sx plug @700'  
Set 15 sx plug 40" to 0"

Sand & Red Bed  
Red bed  
Red Bed, Shale-Anhydrite  
Shale & Anhydrite  
Shale, Red Bed, Anhydrite  
Shale  
Lime-Shale  
Lime-Shale-Snad  
Lime-Sand  
Lime  
TD

0-345  
345-655  
655-1245  
1245-1595  
1595-2306  
2306-2558  
2558-4933  
4933-5047  
5017-5100  
5100-5118  
#5118

RECEIVED  
STATE DEPARTMENT OF GEOLOGY  
JUN 30 1966  
CONSERVATION DIVISION

This is a true and exact copy of the formation taken from  
The Daily Drilling Reports.

T. W. Mahoney  
T. W. Mahoney, President

State of Kansas  
County of Seward

Sworn to before me this 28 Day of June, 1966

George W. Carnahan, Jr.  
George W. Carnahan, Jr.  
Notary Public

MY Commission expires January 24, 1968