

STATE OF KANSAS
STATE CORPORATION COMMISSION

15-129-30007-0000

WELL PLUGGING RECORD

Give All Information Completely
Make Required Affidavit
Mail or Deliver Report to:
Conservation Division
State Corporation Commission
211 No. Broadway
Wichita, Kansas

Morton County, Sec. 31 Twp. 31S Rge. 1(E) 42 (W)

Location as "NE/CNW/SW" or footage from lines C SW/4 NE/4

Lease Owner Graham-Michaelis Drilling Company

Lease Name Bender Well No. 1-31

Office Address 211 North Broadway, Wichita, Kansas 67202

Character of Well (completed as Oil, Gas or Dry Hole) Dry Hole

Date well completed March 12, 1965

Application for plugging filed (verbal) March 12, 1965

Application for plugging approved (verbal) March 12, 1965


Plugging commenced March 12, 1965

Plugging completed March 12, 1965

Reason for abandonment of well or producing formation Non commercial

If a producing well is abandoned, date of last production ----- 19

Was permission obtained from the Conservation Division or its agents before plugging was commenced? yes

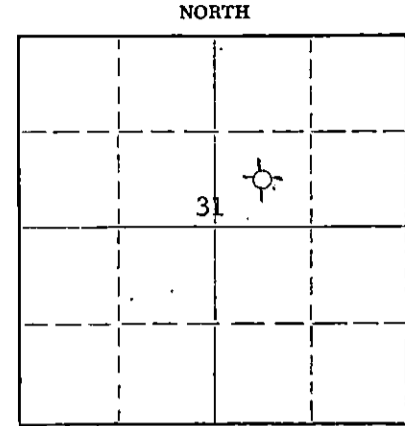

Locate well correctly on above Section Plat

Name of Conservation Agent who supervised plugging of this well Hugh Scott, Sublette, Kansas

Producing formation none Depth to top ----- Bottom ----- Total Depth of Well 5356 Feet

Show depth and thickness of all water, oil and gas formations.

OIL, GAS OR WATER RECORDS

CASING RECORD

FORMATION	CONTENT	FROM	TO	SIZE	PUT IN	PULLED OUT
				8 5/8"	1440'	none

Describe in detail the manner in which the well was plugged, indicating where the mud fluid was placed and the method or methods used in introducing it into the hole. If cement or other plugs were used, state the character of same and depth placed, from ----- feet to ----- feet for each plug set.

Hole was filled with heavy drilling mud. Cement plug (35 sx cement) at 700'
Hole was filled with heavy drilling mud. Cement plug (15 sx cement) at 45'.
Cement plug at top of surface casing.

RECEIVED
STATE CORPORATION COMMISSION
APR 5 1965
CONSERVATION DIVISION
Wichita, Kansas

(If additional description is necessary, use BACK of this sheet)
Name of Plugging Contractor Graham-Michaelis Drilling Company
Address 211 North Broadway, Wichita, Kansas 67202

STATE OF Kansas, COUNTY OF Sedgwick, ss.
Jack L. Yinger (employee of owner) or (owner or operator) of the above-described well, being first duly sworn on oath, says: That I have knowledge of the facts, statements, and matters herein contained and the log of the above-described well as filed and that the same are true and correct. So help me God.

(Signature) Jack L. Yinger
211 North Broadway, Wichita, Kansas 67202
(Address)

SUBSCRIBED AND SWORN TO before me this 2nd day of April, 1965
Evelyn D. Evans
Evelyn D. Evans Notary Public.

My commission expires December 12, 1966



BENDER #1-31

15-129-30007-0000

WELL RECORD:

LOCATION:

C SW NE Section 31-31S-42W
Morton County, Kansas

Commenced: 2-26-65
Completed: 3-13-65
(Rotary)

CONTRACTOR:

Graham-Michaelis Drilling, Inc.
Liberal Division
P. O. Box 1294
Liberal, Kansas

CASING RECORD:

45 Joints 24# 8-5/8" Casing
Cemented w/500 sx Trinity Lt. Wt.
2% cc and w/200 sx Common 2% cc

	<u>LOG</u>
Sand & Red Bed	0 - 1050
Red Bed	1050 - 1614
Red Bed & Shale	1614 - 2037
Lime & Shale	2037 - 4545
Lime	4545 - 4749
Shale	4749 - 4856
Lime & Shale	4856 - 5193
Lime	5193 - 5250
Lime & Shale	5250 - 5356

5356' - Total Rotary Depth

The undersigned, Graham-Michaelis Drilling, Inc., Liberal Division, certifies that the above log is a true and correct copy of the formations encountered in drilling the above mentioned well, as taken from the Daily Drilling Report.

GRAHAM-MICHAELIS DRILLING, INC.
LIBERAL DIVISION

By H. R. Michaelis
H. R. Michaelis

RECEIVED
STATE CORPORATION COMMISSION
APR 5 1965
CONSERVATION DIVISION
Wichita, Kansas