


STATE OF KANSAS  
STATE CORPORATION COMMISSION

15-129-10064-0000 Form CP-4

WELL PLUGGING RECORD

Give All Information Completely  
Make Required Affidavit  
Mail or Deliver Report to:  
Conservation Division  
State Corporation Commission  
211 No. Broadway  
Wichita, Kansas

NORTH

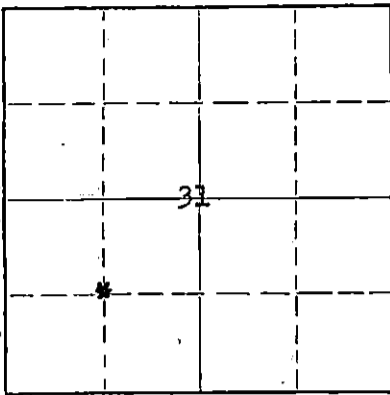

Locate well correctly on above  
Section Plat

Morton County, Sec. 31 Twp. 31 Rge. (E) 42(W)  
Location as "NE/CNW%SW%" or footage from lines C SW/4  
Lease Owner Colorado Oil & Gas Corporation (Superior)  
Lease Name Schrader Well No. 1-31  
Office Address P.O. Box 158, Liberal, Kansas 67901  
Character of Well (completed as Oil, Gas or Dry Hole) Gas  
Date well completed 1-19 19 66  
Application for plugging filed 12-20 19 66  
Application for plugging approved 12-21 19 66  
Plugging commenced 12-26 19 66  
Plugging completed 12-30 19 66  
Reason for abandonment of well or producing formation Uneconomical

If a producing well is abandoned, date of last production 19  
Was permission obtained from the Conservation Division or its agents before plugging was commenced? Yes

Name of Conservation Agent who supervised plugging of this well \_\_\_\_\_  
Producing formation Elmont Depth to top \_\_\_\_\_ Bottom \_\_\_\_\_ Total Depth of Well 3147 Feet  
Show depth and thickness of all water, oil and gas formations.

OIL, GAS OR WATER RECORDS

CASING RECORD

FORMATION	CONTENT	FROM	TO	SIZE	PUT IN	PULLED OUT
<u>Elmont</u>		<u>3096</u>	<u>99</u>			
		<u>3108</u>	<u>13</u>			
		<u>3122</u>	<u>26</u>			

Describe in detail the manner in which the well was plugged, indicating where the mud fluid was placed and the method or methods used in introducing it into the hole. If cement or other plugs were used, state the character of same and depth placed, from none feet to \_\_\_\_\_ feet for each plug set.

Mixed 20 sacks cement and 2 sacks hulls -- run on bottom to 3000'. Mud to 500'. Ran 40 sack cement plug at 500' to 375'. Ran mud to 40' set bridge plug and ran 10 sack cement from top of plug to 15' below ground level.

RECEIVED  
STATE CORPORATION COMMISSION

JAN 12 1967

CONSERVATION DIVISION  
Wichita, Kansas

(If additional description is necessary, use BACK of this sheet)  
Name of Plugging Contractor Sargent's Casing Pulling Service  
Address Box 506, Liberal, Kansas 67901

STATE OF Kansas, COUNTY OF Seward, ss.  
L.H. Walters (employee of owner) or (owner or operator) of the above-described well, being first duly sworn on oath, says: That I have knowledge of the facts, statements, and matters herein contained and the log of the above-described well as filed and that the same are true and correct. So help me God:

cc: AJ Smith (Signature) L.H. Walters  
Bill Stinson P.O. Box 158, Liberal, Kansas 67901  
File (Address)

SUBSCRIBED AND SWORN TO before me this 11th day of January, 19 67

William B. Claunch  
Notary Public.

My commission expires 11/1/70

# WELL LOG

15-179-10069-0000

COMPANY THE SUPERIOR OIL COMPANY  
FARM Schrader Unit NO. 131


SEC. 31 T. 31 R. 42W  
LOG. C SW

TOTAL DEPTH 3630'

COUNTY Morton

COMM. November 26, 1955 COMP. December 8, 1955

CONTRACTOR GARVEY DRILLING COMPANY

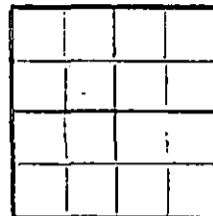

CASING 10-3/4" @ 684' w/450 sacks  
7" @ 3629' w/450 sacks

ELEVATION 3549 D.F.

PRODUCTION

FIGURES INDICATE BOTTOM OF FORMATIONS

20	Surface Soil
55	Clay & Sand
135	Red Bed
460	Red Bed & Shells
719	Red Bed, Shale & Shell Streaks
900	Red Bed
985	Sand
1075	Red Bed & shells
1180	Sand
1400	Red Bed
1460	Red Bed & Anhydrite Streaks
1600	Red Bed & Shale
1810	Red Bed Shale & Shells
2065	Red Bed & Shells
2173	Red Bed & Lime
2355	Shale, Lime & Shells
2432	Shale & Lime
2663	Lime
2880	Shale & Lime
2946	Lime
3055	Lime & Shale
3582	Lime
3630	Lime & Shale
3630	T.D.

RECEIVED  
STATE CORPORATION COMMISSION

DEC 21 1966

CONSERVATION DIVISION  
Wichita, Kansas

State of KANSAS  
County of SEDGWICK

I, Robert F. White of GARVEY DRILLING COMPANY

do hereby state that the above and foregoing is a true and correct copy of the log of the #131 Schrader Unit

Subscribed and sworn to before me this 19th day of December 19 55

My Commission Expires: August 8, 1959

NOTARY PUBLIC