


15-129-16084-0000

WELL PLUGGING RECORD

Give All Information Completely
Make Required Affidavit
Mail or Deliver Report to:
Conservation Division
State Corporation Commission
211 No. Broadway
Wichita, Kansas

Morton County, Sec. 35 Twp. 31S Rge. (E) 42 (W)
Location as "NE/CNW/SWK" or footage from lines C SE/4
Lease Owner: Graham-Michaelis Drilling Company
Lease Name Matzen Well No. 1-35
Office Address 211 North Broadway, Wichita 2, Kansas
Character of Well (completed as Oil, Gas or Dry Hole) Dry Hole
Date well completed January 26, 19 63
Application for plugging filed January 26, 19 63
Application for plugging approved (Verbal) January 26, 19 63
Plugging commenced January 26, 19 63
Plugging completed January 26, 19 63
Reason for abandonment of well or producing formation Dry Hole

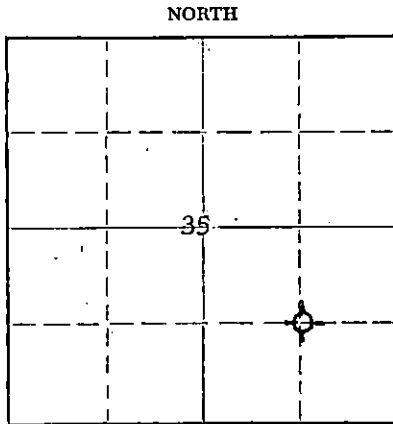

Locate well correctly on above Section Plat

If a producing well is abandoned, date of last production -----19-----
Was permission obtained from the Conservation Division or its agents before plugging was commenced? Yes

Name of Conservation Agent who supervised plugging of this well Hugh E. Scott, Liberal, Kansas
Producing formation ----- Depth to top ----- Bottom ----- Total Depth of Well 5250' Feet
Show depth and thickness of all water, oil and gas formations.

OIL, GAS OR WATER RECORDS

CASING RECORD

FORMATION	CONTENT	FROM	TO	SIZE	PUT IN	PULLED OUT
				8 5/8"	@ 1457'	none

Describe in detail the manner in which the well was plugged, indicating where the mud fluid was placed and the method or methods used in introducing it into the hole. If cement or other plugs were used, state the character of same and depth placed, from ----- feet to ----- feet for each plug set.

Filled hole with heavy drilling mud, put a cement plug at 3250' with 50 sx cement. cement plug at 700' with 35 sx cement, filled with heavy drilling mud and cement plug at 40' with 15 sx. cement plug on top.

RECEIVED
STATE CORPORATION COMMISSION

FEB 6 1963

DRILLER'S LOG ATTACHED

CONSERVATION DIVISION
Wichita, Kansas

(If additional description is necessary, use BACK of this sheet)
Name of Plugging Contractor Graham-Michaelis Drilling Company
Address 211 North Broadway, Wichita 2, Kansas

STATE OF KANSAS, COUNTY OF SEDGWICK, ss.
John L. James (employee of owner) or (owner or operator) of the above-described well, being first duly sworn on oath, says: That I have knowledge of the facts, statements, and matters herein contained and the log of the above-described well as filed and that the same are true and correct. So help me God.

(Signature) John L. James Geologist
211 North Broadway, Wichita 2, Kansas
(Address)

SUBSCRIBED AND SWORN TO before me this 5th day of February, 19 63

Evelyn D. Evans
Notary Public.

My commission expires December 12, 1966

15-129-10084.0000

MATZEN #1-35

WELL RECORD:

LOCATION:

C SE/4 Section 35-31S-42W
Morton County, Kansas

Commenced: 1-14-63
Completed: 1-27-63
(Rotary)

CONTRACTOR:

Graham-Michaelis Drilling Co.
Liberal Division
P. O. Box 1294
Liberal, Kansas

CASING RECORD:

48 Joints 8-5/8" 24# Casing
Cemented w/475 sx Trinity Lt.
Wt. 2% cc followed w/200 sx
Sunset

LOG

Sand, Red Bed & Gyp	0 - 1033
Red Bed, Gyp & Anhy	1033 - 1256
Red Bed & Gyp	1256 - 1440
Anhy	1440 - 1458
Anhy & Red Bed	1458 - 1698
Anhy, Gyp & Shale	1698 - 2195
Shale	2195 - 2355
Shale, Sand & Lime	2355 - 2594
Shale & Lime	2594 - 2725
Chalk	2725 - 2832
Shale, Lime & Chalk	2832 - 2874
Shale & Lime	2874 - 2881
Chalk	2881 - 2888
Shale & Lime	2888 - 2920
Chalk	2920 - 2926
Shale & Lime	2926 - 3072
Chalk	3072 - 3085
Shale & Lime	3085 - 3140
Chalk	3140 - 3165
Shale & Lime	3165 - 3201
Chalk	3201 - 3246
Shale & Lime	3246 - 3256
Chalk	3256 - 3277
Shale & Lime	3277 - 3423
Chalk	3323 - 3330
Shale & Lime	3330 - 3383
Chalk	3383 - 3403
Shale & Lime	3403 - 3425
Chalk	3425 - 3442
Shale & Lime	3442 - 3500
Chalk	3500 - 3507
Shale & Lime	3507 - 3688
Chalk	3688 - 3708
Shale & Lime	3708 - 3847
Chalk	3847 - 3864
Shale & Lime	3864 - 3881
Chalk	3881 - 3898
Lime, Shale & Chalk	3898 - 3929
Lime & Shale	3929 - 4468
Shale	4468 - 4617
Shale & Lime	4617 - 4979
Shale & Sand	4979 - 5250

5250' - Total Rotary Depth

RECEIVED
STATE CORPORATION COMMISSION

FEB 6 1963

CONSERVATION DIVISION
Wichita, Kansas

The undersigned, Graham-Michaelis Drilling Company, Liberal Division, certifies that the above log is a true and correct copy of the formations encountered in drilling the above mentioned well, as taken from the Daily Drilling Report.

GRAHAM-MICHAELIS DRILLING COMPANY
LIBERAL DIVISION

By: 
H. R. Michaelis