


Give All Information Completely  
Make Required Affidavit  
Mail or Deliver Report to:  
Conservation Division  
State Corporation Commission  
800 Bittling Building  
Wichita, Kansas

WELL PLUGGING RECORD

*Morton*

County, Sec. *5-SE* Twp. *35* Rge. *315* (E) (W) *42*

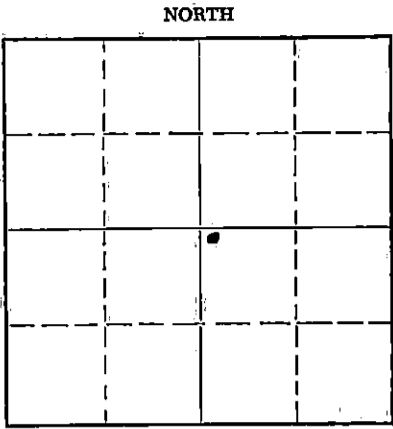

NORTH

Locate well correctly on above Section Plat

Location as "NE/CNW/SW" or footage from lines \_\_\_\_\_  
Lease Owner *The Superior Oil Co of Calif*  
Lease Name *Martin* Well No. \_\_\_\_\_  
Office Address *2221 Liberty Bank Building Okla City Okla*  
Character of Well (completed as Oil, Gas or Dry Hole) *Gas*  
Date well completed \_\_\_\_\_ 19 *58*  
Application for plugging filed *Sept 4* 19 *62*  
Application for plugging approved *Sept 7* 19 *62*  
Plugging commenced *Sept 8* 19 *62*  
Plugging completed *Sept 8* 19 \_\_\_\_\_  
Reason for abandonment of well or producing formation *depleted*

If a producing well is abandoned, date of last production \_\_\_\_\_ 19 \_\_\_\_\_  
Was permission obtained from the Conservation Division or its agents before plugging was commenced? *yes*

Name of Conservation Agent who supervised plugging of this well *Hugh Scott*  
Producing formation *Niputon* Depth to top \_\_\_\_\_ Bottom \_\_\_\_\_ Total Depth of Well ~~2873~~ Feet *3326*  
Show depth and thickness of all water, oil and gas formations.

OIL, GAS OR WATER RECORDS

CASING RECORD

FORMATION	CONTENT	FROM	TO	SIZE	PUT IN	PULLED OUT
		0	2873	7"	2873	11 47
		0	800	8"		

Describe in detail the manner in which the well was plugged, indicating where the mud fluid was placed and the method or methods used in introducing it into the hole. If cement or other plugs were used, state the character of same and depth placed, from \_\_\_\_\_ feet to \_\_\_\_\_ feet for each plug set.

*Plug bottom from 2873 to 2800 w/ sand capped w/ 5 sks cement. Fill with heavy mud from 2800 to 700. Plug and 35 sks cement from 1700 to 590. Mud from 1590 to 45 ft. Plug and 15 sks cement to surface.*

RECEIVED  
STATE CORPORATION COMMISSION

SEP 10 1962

CONSERVATION DIVISION  
Wichita, Kansas

(If additional description is necessary, use BACK of this sheet)  
Name of Plugging Contractor *Sargeant's Logging & Pulling Service*  
Address *121 West 19th Liberal Kansas*

STATE OF *Kansas*, COUNTY OF \_\_\_\_\_, ss. \_\_\_\_\_ (employee of owner) or (owner or operator) of the above-described well, being first duly sworn on oath, says: That I have knowledge of the facts, statements, and matters herein contained and the log of the above-described well as filed and that the same are true and correct. So help me God.

(Signature) *Robert Sargeant*  
*121 W 19th Liberal Kan*  
(Address)

SUBSCRIBED AND SWORN TO before me this *10<sup>th</sup>* day of *September*, 19*62*  
*Robert Keating*  
Notary Public.

WELL LOG BUREAU—KANSAS GEOLOGICAL SOCIETY

508 East Murdock,

Wichita, Kansas

COPY


15-129-1016-000

Company. SUPERIOR OIL CO.  
Farm. Martin No. 1

SEC. 35 T. 31 R. 42W  
C SW/4

Total Depth. 3323  
Comm. 8-10-55 Comp. 8-19-55  
Shot or Treated.  
Contractor. Midwestern Drillers, Inc.  
Issued. 9-15-56

County Morton  
KANSAS

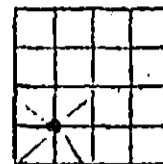

CASING:

10 3/4 694' w/ 450 sx cmt.  
7 in. 3335' w/ 400 sx cmt.

Elevation. 3482

Production. 2,000,000 CFGPD

Figures indicate Bottom of Formations.

sand & red bed	325
sand & shale	525
red bed	710
red bed & shale	995
gyp	1060
red bed	1316
shale & gyp	1840
shale & shells	1993
gyp & shale	2630
dolomite & shale	2690
shale & gyp	2840
broken lime & shale	2980
lime & shale	3323
Total Depth	
Schlumberger T. D.	3326
TOPS:	
Wabaunsee	2813
Elmont	3061
Topeka	3230

Ran Schlumberger E. L.