


WELL PLUGGING RECORD

Give All Information Completely
Make Required Affidavit
Mail or Deliver Report to:
Conservation Division
State Corporation Commission
211 No. Broadway
Wichita, Kansas

Morton County, Sec. 12 Twp. 31S Rge. (E) 42 (W)

Location as "NE/CNW/SW" or footage from lines C NE
Lease Owner Whitestone Petroleum Corporation
Lease Name M. R. JOHNS Well No. 1
Office Address 900 Vaughn Bldg., Dallas 1, Texas
Character of Well (completed as Oil, Gas or Dry Hole) Dry Hole
Date well completed - - 19 --
Application for plugging filed December 1 19 62
Application for plugging approved December 3 19 62
Plugging commenced December 6 19 62
Plugging completed December 10 19 62
Reason for abandonment of well or producing formation No Commercial Zones

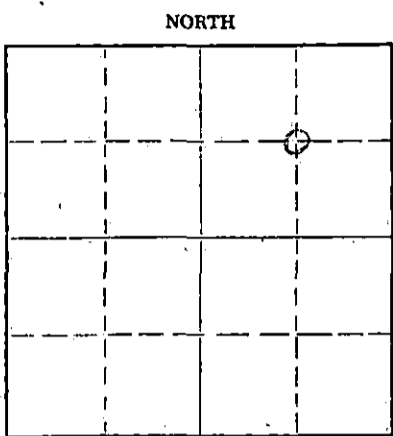

Locate well correctly on above Section Plat

If a producing well is abandoned, date of last production - - 19 --
Was permission obtained from the Conservation Division or its agents before plugging was commenced? Yes

Name of Conservation Agent who supervised plugging of this well Mr. Hugh E. Scott
Producing formation - - Depth to top - - Bottom - - Total Depth of Well 5600 Feet
Show depth and thickness of all water, oil and gas formations.

OIL, GAS OR WATER RECORDS

CASING RECORD

FORMATION	CONTENT	FROM	TO	SIZE	PUT IN	PULLED OUT
				8-5/8"	1660'	0'
				4-1/2"	5556'	2820'

Describe in detail the manner in which the well was plugged, indicating where the mud fluid was placed and the method or methods used in introducing it into the hole. If cement or other plugs were used, state the character of same and depth placed, from _____ feet to _____ feet for each plug set.

Pumped cement in hole through 2" tubing as follows:

From Bottom to Top:

5100' - 4000' Sand Bridge with 5 Sacks Cement on Top
4000' - 600' Heavy Mud
600' - 500' Sand Bridge
500' - 50' Heavy Mud
50' - 35' Crushed Rock Bridge
35' - 0 15-Sack Cement Plug

RECEIVED
STATE CORPORATION COMMISSION

DEC 12 1962

CONSERVATION DIVISION
Wichita, Kansas

(If additional description is necessary, use BACK of this sheet)
Name of Plugging Contractor Sargents Casing Pulling Service
Address 121 West Ninth Street, Liberal, Kansas

STATE OF TEXAS, COUNTY OF DALLAS, ss.
Dale O. Chase (employee of owner) or OWNER'S REPRESENTATIVE of the above-described

well, being first duly sworn on oath, says: That I have knowledge of the facts, statements, and matters herein contained and the log of the above-described well as filed and that the same are true and correct. So help me God.

(Signature) Dale O. Chase

900 Vaughn Bldg., Dallas 1, Texas
(Address)

SUBSCRIBED AND SWORN TO before me this 11th day of December, 19 62

My commission expires 6/1/63

Emmanuel Coody
Notary Public.

WELL LOG
15-129-10181-0200

COMPANY WHITESTONE PETROLEUM

SEC. 12 T. 31S R. 42W

FARM M. R. JOHNS

NO. 1

LOC. C-NE/4


TOTAL DEPTH 5600'

COUNTY MORTON CO., KANSAS

COMM. October 19, 1962

COMP. November 5, 1962

CONTRACTOR GARVEY DRILLING COMPANY

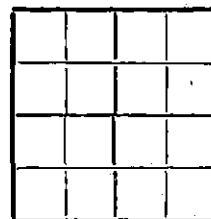

CASING 8-5/8" @ 1660' w/760 sax.
4 1/2" @ 5545' w/350 sax.

ELEVATION

RECEIVED
STATE CORPORATION COMMISSION

PRODUCTION

DEC 3 1962

FIGURES INDICATE BOTTOM OF FORMATIONS

CONSERVATION DIVISION
Wichita, Kansas

105	Surface clay & shale
610	Shale & red bed
920	Gyp & red bed
1120	Shale, sand & shells
1490	Shale, lime & sand
1508	Shale
1535	Anhydrite
1660	Shale & anhydrite
1675	Anhydrite
1830	Shale & shells
2210	Shale
2685	Shale & lime
3345	Lime & shale
3380	Lime
3525	Lime & shale
4626	Lime
4785	Lime & shale
4838	Lime
5020	Lime & shale
5155	Shale & lime
5255	Shale & sand
5332	Shale, sand & lime
5400	Lime & chert
5438	Lime
5579	Lime & chert
5600	Lime
5600	T. D.

State of KANSAS }
County of BARTON } SS

I, VERNE A. MORRIS of GARVEY DRILLING COMPANY

upon oath state the above and foregoing is a true and correct copy of the log of the #1 M.R. JOHNS well.

Verne A. Morris

Subscribed and sworn to before me this 16th day of November 19 62

My Commission Expires: October 24, 1966

Brantley
NOTARY PUBLIC