


WELL PLUGGING RECORD

Give All Information Completely
Make Required Affidavit
Mail or Deliver Report to:
Conservation Division
State Corporation Commission
211 No. Broadway
Wichita, Kansas

NORTH

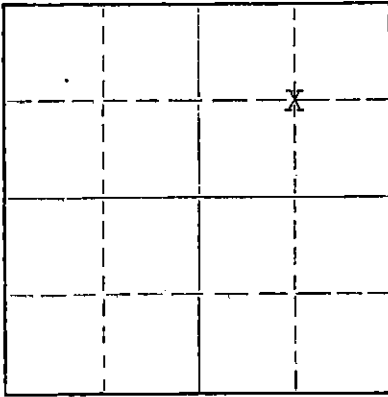

Locate well correctly on above
Section Plat

Morton County, Sec. 11 Twp 31S Rgd 2 (E) (W)
Location as "NE/CNW/SW" or footage from lines C NE/4
Lease Owner J. M. Huber Corporation
Lease Name Collinwood Well No. 1
Office Address P. O. Box 978, Liberal, Kansas
Character of Well (completed as Oil, Gas or Dry Hole) Gas
Date well completed June 15 1956
Application for plugging filed March 2 19 64
Application for plugging approved March 4 19 64
Plugging commenced March 7 19 64
Plugging completed March 9 19 64
Reason for abandonment of well or producing formation Depleted

If a producing well is abandoned, date of last production 2-2 19 62
Was permission obtained from the Conservation Division or its agents before plugging was commenced? Yes

Name of Conservation Agent who supervised plugging of this well Hugh Scott
Producing formation Morrow Depth to top 5207 Bottom 5251 Total Depth of Well 5323 Feet
Show depth and thickness of all water, oil and gas formations. PBTD 2955

OIL, GAS OR WATER RECORDS

CASING RECORD

FORMATION	CONTENT	FROM	TO	SIZE	PUT IN	PULLED OUT
Morrow "G" Sand	Gas	5207	5235	8 5/8"	1520	0
Keyes Sand	Gas	5241	5251	5 1/2"	5321	2305

Describe in detail the manner in which the well was plugged, indicating where the mud fluid was placed and the method or methods used in introducing it into the hole. If cement or other plugs were used, state the character of same and depth placed, from _____ feet to _____ feet for each plug set.

35 sx cement plug pumped in hole from 2775 to 2955
Mud to 700 feet
Cement plug pumped in to cover 700' to 595'
Mud to 45'
Cement plug 45' to surf.
Steel plate welded on surface 4' below ground level.

RECEIVED
STATE CORPORATION COMMISSION

MAR 13 1964

CONSERVATION DIVISION
Wichita, Kansas

(If additional description is necessary, use BACK of this sheet)

Name of Plugging Contractor Daco Well Service
Address Borger, Texas

STATE OF KANSAS, COUNTY OF SEWARD, ss.
Harold Jones (employee of owner) or (owner or operator) of the above-described well, being first duly sworn on oath, says: That I have knowledge of the facts, statements, and matters herein contained and the log of the above-described well as filed and that the same are true and correct. So help me God.

(Signature) Harold Jones
P. O. Box 978, Liberal, Kansas
(Address)

SUBSCRIBED AND SWORN to before me this 12th day of March, 19 64

My commission expires March 8, 1967

Mary Kay [Signature]
Notary Public.

copy for file

WELL LOG

Collingwood Well #1

15-179-00022-0000

Location: Sec. 11-31S-42W, Morton County, Kansas

Operator: J. M. Huber Corporation

Contractor: Holm Drilling Company

Commenced: 5-19-56

Spud: 5-19-56

Rotary Work Completed: 6-8-56

Rotary Depth: 5320' K.B.

Casing Record: 8 5/8" set @ 1511' Ground Level
5 1/2" set @ 5311' " "

<u>FORMATION</u>	<u>DEPTH</u>
Clay	110'
Sand	120'
Clay and Shale	228'
Shale, shells, and Sand	515'
Redbed	605'
Redbed and Shells	985'
Gyp and Shale	1090'
Gyp	1146'
Shale and Shells	1190'
Sand and Shale	1325'
Shale and Shells	1485'
Shale and Anhydrite	1515'
Anhydrite	1520'
Shale and Shells	2180'
Shale and Anhydrite	2260'
Shale	2280'
Shale and Lime	2945'
Lime	2968'
Shale	3050'
Lime and Shale	3550'
Cherty Lime and Shale	3622'
Lime and Shale	3940'
Lime	4037'
Lime and Shale	4250'
Lime	4814'
Shale	5150'
Sandy Lime	5185'
Cored Hole	5259'
Sand and Shale	5320' T.D. - K. B.

RECEIVED
STATE CORPORATION COMMISSION
MAR 13 1964
CONSERVATION DIVISION
Wichita, Kansas

Certified copy of Well Log

HOLM DRILLING COMPANY

By F. M. Rush
F. M. Rush