

STATE OF KANSAS
STATE CORPORATION COMMISSION

15-129-10090-0000

WELL PLUGGING RECORD

Give All Information Completely
Make Required Affidavit
Mail or Deliver Report to
Conservation Division
State Corporation Comm.
245 North Water
Wichita, KS 67202

Morton County, Sec. 11 Twp. 31S Rge. 42 ~~EX~~W
Location as "NE/CNW/SW" or footage from lines
1240' FSL & 1400' FEL


Lease Owner J.M. Huber Corporation
Lease Name Collingwood Well No. 2
Office Address 2450 Liberty Tower, Okla. City, Okla. 73102
Character of Well (Completed as Oil, Gas or Dry Hole)
Gas

Date Well completed 9/16 19 57
Application for plugging filed 12/15 19 78
Application for plugging approved 12/19 19 78
Plugging commenced 2/5 19 79
Plugging completed 2/12 19 79

Reason for abandonment of well or producing formation
Watered-out
If a producing well is abandoned, date of last production
7/1 19 78

Was permission obtained from the Conservation Division or
its agents before plugging was commenced? Yes

Name of Conservation Agent who supervised plugging of this well Clarence Thomas
Producing formation Keyes Depth to top 5246 Bottom 5256 Total Depth of Well 5320
Show depth and thickness of all water, oil and gas formations.

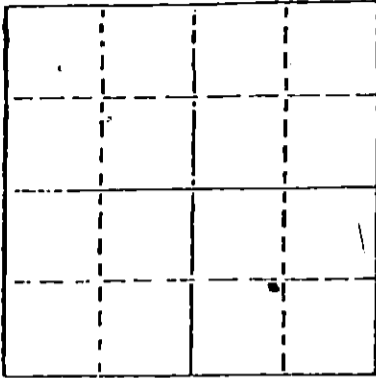

Locate well correctly on above
Section Plat

OIL, GAS OR WATER RECORDS

CASING RECORD

FORMATION	CONTENT	FROM	TO	SIZE	PUT IN	PULLED OUT
Keyes	Gas	5246	5256	8 5/8	1519'	None
				5 1/2	5315'	1890'

Describe in detail the manner in which the well was plugged, indicating where the mud fluid was placed and the method or methods used in introducing it into the hold. If cement or other plugs were used, state the character of same and depth placed, from _____ feet to _____ feet for each plug set.

Spotted 25 sx Class H cement with 1/4# Flocele per sk from 5230-5130'.

Spotted 50 sx Class H cement from 1569-1469'.

Spotted 10 sx Class H cement from 33'-3'.

Welded steel plate on surface casing.

RECEIVED
STATE CORPORATION COMMISSION
FEB 20 1979
CONSERVATION DIVISION
Wichita, Kansas

(If additional description is necessary, use BACK of this sheet)

Name of Plugging Contractor Lillard Casing Pullers

STATE OF Kansas COUNTY OF Morton, ss.
Leo E. Woodard (employee of owner) or (owner or operator)
of the above-described well, being first duly sworn on oath, says: That I have knowledge of the facts, statements, and matters herein contained and the log of the above-described well as filed and that the same are true and correct. So help me God.

(Signature) Leo E Woodard
2450 Liberty Tower, Oklahoma City, Okla. 73102
(Address)

SUBSCRIBED AND SWORN TO before me this 16th day of February, 1979

My Commission Expires Oct. 23, 1982

My commission expires _____ My Commission Expires Oct 22 1982

Betty J. Linn
Notary Public.