


STATE OF KANSAS  
STATE CORPORATION COMMISSION

Give All Information Completely  
Make Required Affidavit  
Mail or Deliver Report to:  
Conservation Division  
State Corporation Commission  
212 No. Market  
Wichita, Kansas

15-129-20018-0000 Form CP

WELL PLUGGING RECORD

NORTH

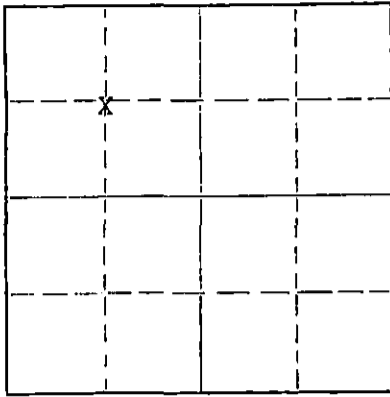

Locate well correctly on above  
Section Plat

Morton County, Sec. 3 Twp. 31S Rge. (E) 42 (W)

Location as "NE/CNW/SW" or footage from lines C NW- $\frac{1}{4}$   
Lease Owner The Superior Oil Company  
Lease Name Purcell Unit Well No. 1  
Office Address P.O. Box 200, Casper, Wyoming 82601  
Character of Well (completed as Oil, Gas or Dry Hole) Gas  
Date well completed November 30, 1955  
Application for plugging filed September 8, 1970  
Application for plugging approved September 9, 1970  
Plugging commenced September 21, 1970  
Plugging completed September 24, 1970  
Reason for abandonment of well or producing formation Well depleted

If a producing well is abandoned, date of last production July 28, 1970  
Was permission obtained from the Conservation Division or its agents before plugging was commenced? Yes

Name of Conservation Agent who supervised plugging of this well Mr. E. Eves  
Producing formation Morrow (Gas) Depth to top 5140 Bottom 5322 Total Depth of Well 5344 Feet  
Show depth and thickness of all water, oil and gas formations.

OIL, GAS OR WATER RECORDS

CASING RECORD

FORMATION	CONTENT	FROM	TO	SIZE	PUT IN	PULLED OUT
Morrow	Gas	5140	5322	10-3/4"	1522'	0
				7"	5340'	2721'

Describe in detail the manner in which the well was plugged, indicating where the mud fluid was placed and the method or methods used in introducing it into the hole. If cement or other plugs were used, state the character of same and depth placed, from \_\_\_\_\_ feet to \_\_\_\_\_ feet for each plug set.  
Pumped 1 sack cottonseed hulls and 25 sacks regular cement to plug perforations (5243-5255'). Plug from 5243' to 5110'. Shot and recovered 2721' of 7" casing. Pumped 60 sack regular cement plug from 700 to 800'. Filled hole to 40' with mud. Dumped 20 sack cement plug from 40' to surface. Cut off casinghead. Welded on plate.

RECEIVED  
STATE CORPORATION COMMISSION  
OCT 7 1970  
CONSERVATION DIVISION  
Wichita, Kansas

(If additional description is necessary, use BACK of this sheet)  
Name of Plugging Contractor Sargent Casing Pullers  
Address Box 506, Liberal, Kansas 67901

STATE OF WYOMING, COUNTY OF NATRONA, ss.  
Herman High (employee of owner) or (owner or operator) of the above-described well, being first duly sworn on oath, says: That I have knowledge of the facts, statements, and matters herein contained and the log of the above-described well as filed and that the same are true and correct. So help me God.

(Signature) Herman High  
P.O. Box 200, Casper, Wyoming 82601  
(Address)

SUBSCRIBED AND SWORN TO before me this 5th day of October, 1970

My commission expires September 9, 1973  
J. R. Voris Notary Public