




WELL PLUGGING RECORD

Give All Information Completely
Make Required Affidavit
Mail or Deliver Report to:
Conservation Division
State Corporation Commission
211 No. Broadway
Wichita, Kansas

Meade County, Sec. 33 Twp. 31 S. Rge. (E) 30 (W)
Location as "NE/CNW/SW" or footage from lines C - SW - SW
Lease Owner J. M. Huber Corporation
Lease Name Stegman Well No. 1
Office Address P O Box 978, Liberal, Kansas
Character of Well (completed as Oil, Gas or Dry Hole) Dry hole
Date well completed September 23, 19 60
Application for plugging filed September 21, 19 60
Application for plugging approved September 21, 19 60
Plugging commenced September 22, 19 60
Plugging completed September 23, 19 60
Reason for abandonment of well or producing formation Dry hole

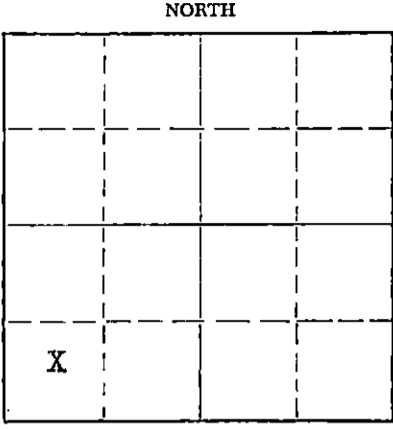

Locate well correctly on above
Section Plat

If a producing well is abandoned, date of last production None 19__
Was permission obtained from the Conservation Division or its agents before plugging was commenced? Yes

Name of Conservation Agent who supervised plugging of this well Mr. Frank Broadfoot
Producing formation None Depth to top _____ Bottom _____ Total Depth of Well 5760 Feet
Show depth and thickness of all water, oil and gas formations.

OIL, GAS OR WATER RECORDS

CASING RECORD

FORMATION	CONTENT	FROM	TO	SIZE	PUT IN	PULLED OUT
<u>Topeka</u>	<u>Salt water</u>	<u>3896</u>	<u>3952</u>	<u>8-5/8</u>	<u>1600'</u>	<u>None</u>
<u>Lansing K.C.</u>	<u>Salt water</u>	<u>4424</u>	<u>4616</u>	<u>4-1/2</u>	<u>4012'</u>	<u>2988'</u>

Describe in detail the manner in which the well was plugged, indicating where the mud fluid was placed and the method or methods used in introducing it into the hole. If cement or other plugs were used, state the character of same and depth placed, from _____ feet to _____ feet for each plug set.

Plugged back 3936'-3916' with sand, and capped with 5 sacks cement with dump bailer. Filled hole full of mud. Shot pipe off at 2988'. Spotted 25 sacks cement thru casing at 1647'-1547' and 25 sacks thru casing at 705'-605'. Filled hole with mud. Spotted 15 sacks cement at top of surface casing. Cut surface pipe off 4' below ground level and welded plate on top.

RECEIVED
STATE CORPORATION COMMISSION

SEP 29 1960

(If additional description is necessary, use BACK of this sheet) CONSERVATION DIVISION
Name of Plugging Contractor D A C O Lease and Well Service Wichita, Kansas
Address 1700 S. Main, Borger, Texas

STATE OF Kansas, COUNTY OF Seward, ss.
Floyd L. Meade (employee of owner) or (~~owner~~) of the above-described well, being first duly sworn on oath, says: That I have knowledge of the facts, statements, and matters herein contained and the log of the above-described well as filed and that the same are true and correct. So help me God.

(Signature) Floyd L. Meade
P O Box 978, Liberal, Kansas
(Address)

SUBSCRIBED AND SWORN TO before me this 27 th day of September, 19 60

My commission expires August 5, 1964
Lydia M. Woods
Notary Public.



WELL LOG

15-119-00114-0000

WELL: Stegman # 1
 OPERATOR: J. M. Huber Corporation
 LOCATION: P O Box 978, Liberal, Kansas
 SW - SW, Sec. 33 - 31 S - 30 W
 Meade County, Kansas
 ELEVATION: 2,756.4'
 RIG COMMENCED: 8-13-60
 RIG COMPLETED: 9- 6-60
 T.D.: 5,760'
 CASING RECORD: 8-5/8" set @ 1,600' with 900 sacks Pozmix plus 2% Calcium Cholride.
 4-1/2" set @ 4,012' with 150 sacks regular cement.
 CASING PULLED: 4-1/2" cut off at 2,988' and pulled.
 PERFORATIONS: Topeka - 3,940'-42' squeezed off
 Topeka - 3,932'-34'

RECEIVED
 STATE CORPORATION COMMISSION
 SEP 29 1960
 CONSERVATION DIVISION
 Wichita, Kansas

This well is D. & A.

FORMATIONS:

Shale-Gyp-Sand	0- 485'	Lime-shale	3743'-3925'
Red bed-shale	485'-1010'	Lime-chalk	3925'-4055'
Red bed-Gyp	1010'-1045'	Lime-shale	4055'-4102'
Sandy Red Bed	1045'-1130'	Lime	4102'-4215'
Sand	1130'-1265'	Lime-shale	4215'-4392'
Red shale-Gyp	1265'-1525'	Lime	4392'-4616'
Red bed	1525'-1577'	Lime-shale	4616'-4705'
Anhydrite	1577'-1665'	Lime	4705'-4740'
Shale-lime	1665'-2910'	Lime-shale	4740'-5476'
Lime	2910'-3105'	Lime-sand	5476'-5502'
Lime-shale	3105'-3285'	Lime-shale	5502'-5530'
Lime-chalk	3285'-3393'	Shale-sand	5530'-5594'
XXXX -Lime-shale	3393'-3574'	Lime-shale	5594'-5760'
Chalk-Lime-shale	3574'-3743'	T.D.	5760'

I the undersigned, being first duly sworn upon oath, state that this well log is true and correct, according to the records of this office, and to the best of my knowledge and belief.

Floyd L. Meade

Floyd L. Meade
 Petroleum Engineer

Subscribed and sworn to before me this 26th day of September 1960.

My commission expires: August 5, 1964

Lydial M. Woods

Notary Public

