


WELL PLUGGING RECORD. 15-175-00426-000

Give All Information Completely
Make Required Affidavit
Mail For Deliver Report to:
Conservation Division
State Corporation Commission
211 No. Broadway
Wichita, Kansas

NORTH

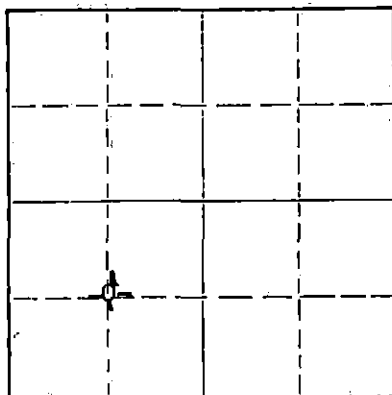

Locate well correctly on above
Section Plat

Seward County. Sec. 7 Twp. 31S Rge. 31W (E) (W)
Location as "NE/CNW/SW" or footage from lines C SW/4
Lease Owner Graham - Michaelis Drilling Co.
Lease Name Schmidt Well No. A-1
Office Address Box 1294 Liberal, Kansas
Character of Well (completed as Oil, Gas or Dry Hole) Gas
Date well completed March 16, 19 55
Application for plugging filed 7-21 19 64
Application for plugging approved 7-28 19 64
Plugging commenced 7-30 19 64
Plugging completed 8-1 19 64
Reason for abandonment of well or producing formation Water and no gas

If a producing well is abandoned, date of last production July 31, 19 64
Was permission obtained from the Conservation Division or its agents before plugging was commenced? Yes

Name of Conservation Agent who supervised plugging of this well High Scott
Producing formation Hugoton Depth to top 2650 Bottom Herrington-Krider Total Depth of Well 2708 Feet
Show depth and thickness of all water, oil and gas formations.

OIL, GAS OR WATER RECORDS

CASING RECORD

FORMATION	CONTENT	FROM	TO	SIZE	PUT IN	PULLED OUT
				8 5/8	575	None
				5 1/2	2707	1212

Describe in detail the manner in which the well was plugged, indicating where the mud fluid was placed and the method or methods used in introducing it into the hole. If cement or other plugs were used, state the character of same and depth placed, from _____ feet to _____ feet for each plug set.

To plug open perforations. Mix 20 sacks of cement and displace with mud. Stop plug at 2408. Mud to 700' and pump 35 sacks cement 700' to 600'. Mud to 45' and 15 sacks cement 45' to 0'. Cut 8 5/8 Off Three feet below ground level and weld cap on same.

RECEIVED
STATE CORPORATION COMMISSION

AUG 14 1964

CONSERVATION DIVISION
Wichita, Kansas

Name of Plugging Contractor Sargents Casing Pulling Service (If additional description is necessary, use BACK of this sheet)
Address Box 506 Liberal, Kansas

STATE OF Kansas, COUNTY OF Sedgwick, ss.

John L. James (employee of owner) or (owner/operator) of the above-described well, being first duly sworn on oath, says: That I have knowledge of the facts, statements, and matters herein contained and the log of the above-described well as filed and that the same are true and correct. So help me God.

(Signature) John L. James John L. James - Geologist

211 North Broadway, Wichita, Kansas
(Address)

SUBSCRIBED AND SWORN to before me this 13 day of August, 19 64.

V. D. Grier
V. D. Grier

Notary Public.

My commission expires January 7, 1965

15-175-00426-0000

3

SCHMIDT NO. 1

Well Record

Commenced: March 3, 1955

Completed: March 8, 1955

Location: Approx. C/ SW/4 Sec. 7-318-31W
Seward County, Kansas.

Elev: 2636 D.F. (Est.)
2632 Gr.

Operator: Michaelis Drilling Company
1019 East Second Street
Wichita, Kansas.

Contractor: Michaelis Drilling Company
1019 East Second Street
Wichita, Kansas.

Casing Record: 8 - 5/8" @ 573.81' w/300 sacks cement
8 - 1/2" @ 2703.50' w/150 sacks cement

LOG

Sand & gravel	250
Sand	378
Gray shale & sand	471
Red shale & sand	512
Red shale	576
Shale & red bed	730
Red bed & gyp	1165
Sand	1370
Red bed	1700
Red bed & gyp streaks	2080
Shale, red bed & gyp	2310
Anhydrite & red bed	2660
Sandy Dolomite w/ shale	2704 RTD

RECEIVED
STATE CORPORATION COMMISSION
AUG 12 1964
CONSERVATION DIVISION
Wichita, Kansas

STATE OF KANSAS)
) as
COUNTY OF SEDGWICK)

The undersigned, MICHAELIS DRILLING COMPANY, hereby certifies that the above log is a true and correct log of the formations encountered in drilling the above well as reflected by the Daily Drilling Report.

MICHAELIS DRILLING COMPANY

By W. A. Michaelis, Jr.
W. A. Michaelis, Jr.
Managing Partner.

Subscribed and sworn to before me this
21st day of March, 1955.

Mary L. Barber
Notary Public.

My commission expires:
Nov. 7, 1957.