


15-175-20669-0000

WELL PLUGGING RECORD

Give All Information Completely
 Make Required Affidavit

COUNTY Seward SEC. 20 TWP. 31S RGE. 31 W
 Location as in quarters or footage from lines:
1320' FSL & 660' FWL

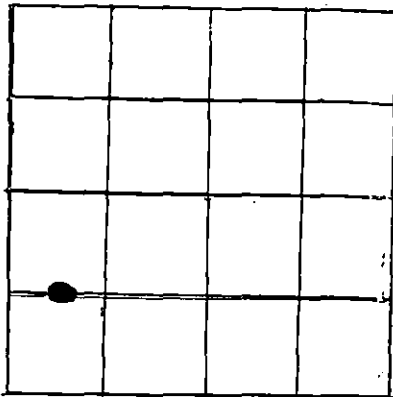

Locate Well
 correctly on above
 Section Platt.

Lease Owner Kelloil, Inc.
 Lease Name Hunt Well No. 1
 Office Address 900 N.P. Anderson Bldg, 411 W. 7th, Ft. Worth, Tx 76102
 Character of Well (Completed as Oil, Gas or Dry Hole): Dry
 Date Well Completed 12-20-82
 Application for plugging filed Verbal approval
 Plugging commenced 12-19-82
 Plugging completed 12-20-82
 Reason for abandonment of well or producing formation Dry Hole

Was permission obtained from the Conservation Division or it's Agent's before plugging was commenced? Yes

Name of Conservation Agent who supervised plugging of this well _____

Producing formation None Depth to top ---- bottom ----- T.D. 5885

Show depth and thickness of all water, oil and gas formations.

OIL, GAS OR WATER RECORDS Casing Record

Formation	Content	From	To	Size	Put in	Pulled Out
				13 3/8"	603	-0-
				8 5/8"	1469	-0-

Describe in detail the manner in which the well was plugged, indicating where the mud fluid was placed and the method or methods used in introducing it into the hold. If cement or other plugs were used, state the character of same and depth placed, from _____ feet to _____ feet for each plug set.

- Spot 50 sx cmt plug from 1520' to 1420'.
- Spot 50 sx cmt plug from 650' to 550'.
- Spot 25 sx cmt plug from 325'-275'.
- Spot 10 sx cmt plug from 40'-0'.
- Cut casing off and welded on steel plate.

(If additional description is necessary, use BACK of this sheet)

Name of Plugging Contractor Halliburton Services, Liberal, Kansas

STATE OF Texas COUNTY OF Tarrant, ss.

John G. Burke/Agent/Kelloil, Inc. (employee of owner) or (owner or operator) of the above-described well, being first duly sworn on oath, says: That I have knowledge of the facts, statements, and matters herein contained and the log of the above-described well as filed and that the same are true and correct. So help me God.

RECEIVED
 STATE CORPORATION COMMISSION

FEB 18 1983

(Signature) John G. Burke
900 N.P. Anderson Bldg.,
411 W. 7th (Address)
Ft. Worth, Tx. 76102
 SUBSCRIBED AND SWORN TO before me this 14th day of February, 1983

CONSERVATION DIVISION
 WICHITA, KANSAS
 SUBSCRIBED AND SWORN TO before me this

Rebecca Baker Ramirez
 Rebecca Baker Ramirez Notary Public

My Commission expires: 7-13-84