

15-175-00014-0000

WELL PLUGGING RECORD

Give All Information Completely
Make Required Affidavit
Mail or Deliver Report to:
Conservation Division
State Corporation Commission
211 No. Broadway
Wichita, Kansas

Seward

County. Sec. 26 Twp. 31S Rge. 31W (E) (W)

Location as "NE/CNW&SWK" or footage from lines. C SW NW

Lease Owner Sinclair Oil & Gas Company

Lease Name E. E. Collingwood Well No. 1

Office Address P. O. Box 521, Tulsa, Oklahoma

Character of Well (completed as Oil, Gas or Dry Hole) Dry Hole

Date well completed 3-18 19 57

Application for plugging filed 3-18 19 57

Application for plugging approved 3-19 19 57


Plugging commenced 3-18 19 57

Plugging completed 3-18 19 57

Reason for abandonment of well or producing formation Dry hole - no producing formation encountered.

If a producing well is abandoned, date of last production Dry Hole 19

Was permission obtained from the Conservation Division or its agents before plugging was commenced? Yes - verbal approval granted.

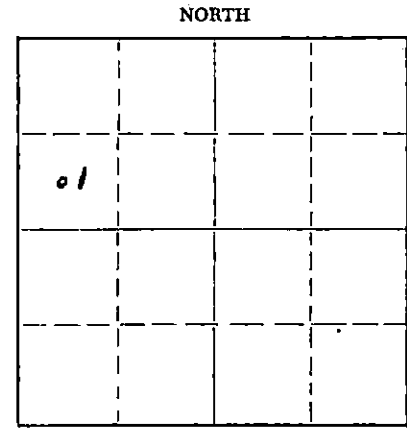

Locate well correctly on above Section Plat

Name of Conservation Agent who supervised plugging of this well Mr. M. A. Rives, Box 8, Pratt, Kansas

Producing formation None Depth to top - Bottom - Total Depth of Well 5700 Feet

Show depth and thickness of all water, oil and gas formations.

OIL, GAS OR WATER RECORDS

CASING RECORD

FORMATION	CONTENT	FROM	TO	SIZE	PUT IN	PULLED OUT
None - Dry Hole				13-3/8	603'	None
				8-5/8	2580	1250'

Describe in detail the manner in which the well was plugged, indicating where the mud fluid was placed and the method or methods used in introducing it into the hole. If cement or other plugs were used, state the character of same and depth placed, from _____ feet to _____ feet for each plug set.

Ran McCullough Magnetector and found 8-5/8" OD Casing free at 1250'.
Cut 8-5/8" OD casing off at 1250' and pulled 1250' of 8-5/8" OD casing.
Filled hole with mud from 5700' to 550'.
Set Halliburton cement plug at 550'.
Dumped 35 sacks of cement 550' to 506'.
Filled hole with mud from 506' to 30'.
Set Halliburton cement plug at 30'.
Dumped 45 sacks of cement 30' to 0'.

RECEIVED
STATE CORPORATION COMMISSION
MAR 29 1957
CONSERVATION DIVISION
Wichita, Kansas

(If additional description is necessary, use BACK of this sheet)
Name of Plugging Contractor Barbour Drilling Company
Address 1612 First National Bldg., Tulsa, Oklahoma

STATE OF Kansas, COUNTY OF Rice, ss.
W. B. Rhees (employee of owner) or (owner) of the above-described well, being first duly sworn on oath, says: That I have knowledge of the facts, statements, and matters herein contained and the log of the above-described well as filed and that the same are true and correct. So help me God.

(Signature) W. B. Rhees
P. O. Box 551, Chase, Kansas
(Address)

SUBSCRIBED AND SWORN TO before me this 28 day of March, 1957
Cred. Warren
Notary Public.

My commission expires April 24-1960

PLUGGING
FILE SEC. 26 T. 31 R. 31W
BOOK PAGE 149 LINE 10

E. E. COLLINGWOOD NO. 1

NW/4 of Section 26-31S-31W
 Seward County, Kansas
 Sinclair Oil and Gas Company

15-175-00014-0000

13-3/8" O. D. casing cemented at 603'
 8-5/8" O. D. casing cemented at 2580'

Drilling commenced February 13, 1957
 Drilling completed March 18, 1957.

FROM	TO	FORMATION	REMARKS
0'	570'	Sand & clay	
570	603	Red bed	13-3/8" O. D. casing cemented with
603	695	Red bed & shale	600 sacks Pozmix at 603'
695	1055	Red bed & sand	
1055	1088	Shale	
1088	1125	Anhydrite	
1125	1143	Sand & shale	
1143	1169	Anhydrite	
1169	1308	Shale & sand	
1308	1394	Shale	
1394	1635	Red bed & anhydrite shells	
1635	1707	Shale & shells	
1707	1730	Anhydrite	
1730	1820	Shells & shale	
1820	1920	Red bed & lime	
1920	2197	Shale & lime	
2197	2226	Lime	
2226	2254	Shale & salt	
2254	2328	Shale & lime	
2328	2444	Lime & shale	
2444	2493	Anhydrite	
2493	2563	Lime & shale	
2563	2565	Anhydrite	
2565	2664	Lime	8-5/8" O. D. casing cemented with
2664	2680	Lime & shale	200 sacks cement at 2580'
2680	2740	Lime	
2740	3190	Lime & shale	
3190	3192	Lime	
3192	3245	Lime & shale	
3245	3450	Lime	
3450	3515	Lime & shale	
3515	3710	Lime	
3710	3830	Lime & shale	
3830	3885	Lime	
3885	3970	Lime, shale & chert	
3970	4568	Lime	
4568	4628	Lime & shale	
4628	4720	Lime	
4720	4771	Lime & shale	

RECEIVED
 STATE CORPORATION COMMISSION
 MAR 29 1957
 CONSERVATION DIVISION
 Wichita, Kansas

PLUGGING			
FILE	SEC	T	R
	26	31	31W
BOOK	PAGE	LI	E
	149		10

15-175-00014-0000


FROM	TO	FORMATION	REMARKS
4771	4905	Lime	
4905	4961	Lime & shale	
4961	5066	Lime	
5066	5126	Lime & shale	
5126	5175	Lime	
5175	5326	Lime & shale	
5326	5359	Lime	
5359	5388	Lime & shale	
5388	5477	Shale & lime	
5477	5570	Lime, shale & Marrow sand	Coring 5489' - 5517'
5570	5655	Lime & shale	Coring 5518' - 5538'
5655	5700	Shale & lime	Coring 5539' - 5569'
			Coring 5570' - 5620'
T.D.	5700'		Well plugged

This is a true copy of the driller's log as shown on the drilling tickets.

BARBOUR DRILLING COMPANY

By: 

Subscribed and sworn to before me on this 26th day of March, 1957

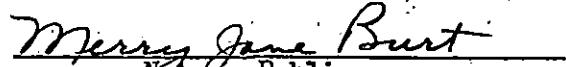
Merry Jane Burt
Notary Public

My commission expires: July 27, 1957

RECEIVED
STATE CORPORATION COMMISSION

MAR 29 1957

CONSERVATION DIVISION
Wichita, Kansas

PLUGGING
FILE SEC 26 T. 31 R. 31 W
BOOK PAGE 149 LINE 10