


15-175-20295-0000

STATE OF KANSAS
STATE CORPORATION COMMISSION

WELL PLUGGING RECORD

Give All Information Completely
Make Required Affidavit
Mail or Deliver Report to
Conservation Division
State Corporation Comm.
245 North Water
Wichita, KS 67202

Seward County, Sec. 30 Twp. 31S Rge. 31 ~~W~~W
Location as "NE/CNW/SW" or footage from lines _____
Approx. 0 NE/4 1320' SofNL 1070' WofEL
Lease Owner Petroleum Inc.
Lease Name Rosson "E" Well No. #1
Office Address P.O. Box 1255 Liberal, Ks. 67901
Character of Well (Completed as Oil, Gas or Dry Hole) _____

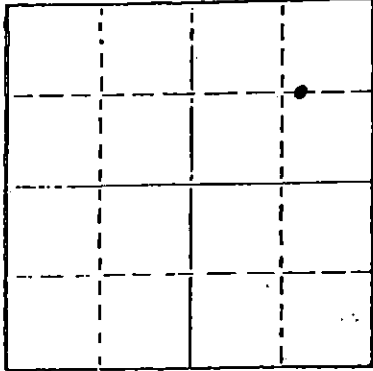

Locate well correctly on above
Section Plot

Dryhole
Date Well completed July 23 1976
Application for plugging filed July 26 1976
Application for plugging approved _____ 19____
Plugging commenced July 25 1976
Plugging completed July 25 1976
Reason for abandonment of well or producing formation _____

Dryhole
If a producing well is abandoned, date of last production _____ 19____

Was permission obtained from the Conservation Division or its agents before plugging was commenced? Yes

Name of Conservation Agent who supervised plugging of this well Mr. Leo Massey
Producing formation _____ Depth to top _____ Bottom _____ Total Depth of Well 5900'
Show depth and thickness of all water, oil and gas formations.

OIL, GAS OR WATER RECORDS

CASING RECORD

FORMATION	CONTENT	FROM	TO	SIZE	PUT IN	PULLED OUT
				8 5/8"	1585'	None

Describe in detail the manner in which the well was plugged, indicating where the mud fluid was placed and the method or methods used in introducing it into the hold. If cement or other plugs were used, state the character of same and depth placed, from _____ feet to _____ feet for each plug set. Plugged w/40 sks. cement 1500-1385

RECEIVED
STATE CORPORATION COMMISSION

10 sks. cement 40-3

5 sks. rathole

5 sks. mousehole

JUL 28 1976

CONSERVATION DIVISION
Wichita, Kansas

(If additional description is necessary, use BACK of this sheet)


Name of Plugging Contractor DaMac Drilling Inc.

STATE OF Kansas COUNTY OF Seward, ss.
Merle Evers (employee of owner)

of the above-described well, being first duly sworn on oath, says: That I have knowledge of the facts, statements, and matters herein contained and the log of the above-described well as filed and that the same are true and correct. So help me God.

(Signature) Merle Evers Petroleum Inc.
P. O. Box 1255 Liberal, Kansas 67901
(Address)

SUBSCRIBED AND SWORN TO before me this 27th day of July, 1976

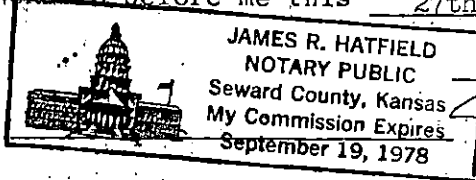

James R. Hatfield
Notary Public.

My commission expires

KANSAS DRILLERS LOG

API No. 15 - 175 - 26295-0000
 County Number

S.30 T. 31S R.31W E W

Loc. NE/4

County Seward

Operator Petroleum, Inc.

Address Box 1255, Liberal, Kansas 67901


Well No. 1 Lease Name Rossen 'E' (unit)

Footage Location
 feet from (N) (S) line feet from (E) (W) line

Principal Contractor DaMac Drilling, Inc. Geologist

Spud Date 7-13-76 Total Depth P.B.T.D.

Date Completed 7-26-76 Oil Purchaser

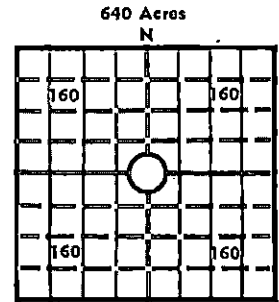

Elev.: Gr. _____

DF _____ KB _____

CASING RECORD

Report of all strings set— surface, intermediate, production, etc.

Purpose of string	Size hole drilled	Size casing set (in O.D.)	Weight lbs/ft.	Setting depth	Type cement	Sacks	Type and percent additives
Surface	12 3/4	8 5/8	24	1585	Lt. Wt FloSeal Class H	650 150	2% CC 3% CC

LINER RECORD

PERFORATION RECORD

Top, ft.	Bottom, ft.	Sacks cement	Shots per ft.	Size & type	Depth interval

TUBING RECORD

Size	Setting depth	Packer set at

ACID, FRACTURE, SHOT, CEMENT SQUEEZE RECORD

Amount and kind of material used

RECEIVED
 STATE CORPORATION COMMISSION

Depth interval treated

OCT 14 1976

CONSERVATION DIVISION
 Wichita, Kansas

INITIAL PRODUCTION

Date of first production Producing method (flowing, pumping, gas lift, etc.)

RATE OF PRODUCTION PER 24 HOURS	Oil	Gas	Water	Gas-oil ratio

Disposition of gas (vented, used on lease or sold) Producing Interval (s)

INSTRUCTIONS: As provided in KCC Rule 82-2-125, within 90 days after completion of a well, one completed copy of this Drillers Log shall be transmitted to the State Geological Survey of Kansas, 4150 Monroe Street, Wichita, Kansas 67209. Copies of this form are available from the Conservation Division, State Corporation Commission, 3830 So. Meridian (P.O. Box 17027), Wichita, Kansas 66217. Phone AC 316-522-2206. If confidential custody is desired, please note Rule 82-2-125. Drillers Logs will be on open file in the Oil and Gas Division, State Geological Survey of Kansas, Lawrence, Kansas 66044.

Operator **Petroleum, Inc.** DESIGNATE TYPE OF COMP.: OIL, GAS, DRY HOLE, SWDW, ETC.:

Well No. **1** Lease Name **Rossen 'E'** Dry Hole

S 30T 31S R 31W ^E/_W

WELL LOG

Show all important zones of porosity and contents thereof; cored intervals, and all drill-stem tests, including depth interval tested, cushion used, time tool open, flowing and shut-in pressures, and recoveries.

SHOW GEOLOGICAL MARKERS, LOGS RUN, OR OTHER DESCRIPTIVE INFORMATION.

FORMATION DESCRIPTION, CONTENTS, ETC.	TOP	BOTTOM	NAME	DEPTH
Sand & Red Bed	0	1180		
Sand	1180	1585		
Anhydrite & Shale	1585	1730		
Red Bed & Gyp	1730	2100		
Shale & Lime	2100	5765		
Lime	5765	5791		
Lime & Shale	5791	5900TD		

USE ADDITIONAL SHEETS, IF NECESSARY, TO COMPLETE WELL RECORD.

Date Received

Martha J. McKeown
Signature

Vice President
Title

July 30, 1976
Date