

STATE OF KANSAS
STATE CORPORATION COMMISSION

15-025-20288-0020

WELL PLUGGING RECORD

Give All Information Completely
Make Required Affidavit
Mail or Deliver Report to
Conservation Division
State Corporation Comm.
245 North Water
Wichita, KS 67202

Clark County, Sec. 22 Twp. 31 Rge. 22 E/W
Location as "NE/CNW $\frac{1}{4}$ SW $\frac{1}{4}$ " or footage from lines
2130' FSL, 1980' FWL of SE/4


Lease Owner Cities Service Company
Lease Name Stover-Harper A Well No. 1
Office Address 3545 N.W. 58th, Okla. City, Okla. 73112
Character of Well (Completed as Oil, Gas or Dry Hole) _____

Dry Hole
Date Well completed 6/11 1979
Application for plugging filed 6/13 1979
Application for plugging approved 6/11 1979
Plugging commenced 6/11 1979
Plugging completed 6/11 1979

Reason for abandonment of well or producing formation _____
Commercial quantities of oil not found
If a producing well is abandoned, date of last production _____
19

Was permission obtained from the Conservation Division or its agents before plugging was commenced? Yes

Name of Conservation Agent who supervised plugging of this well Clarence Thomas, Jr.
Producing formation _____ Depth to top _____ Bottom _____ Total Depth of Well 5274'
Show depth and thickness of all water, oil and gas formations.

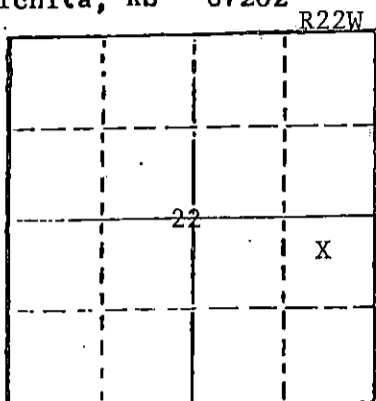

Locate well correctly on above Section Plot

OIL, GAS OR WATER RECORDS

CASING RECORD

FORMATION	CONTENT	FROM	TO	SIZE	PUT IN	PULLED OUT
				8-5/8"	489'	None

Describe in detail the manner in which the well was plugged, indicating where the mud fluid was placed and the method or methods used in introducing it into the hold. If cement or other plugs were used, state the character of same and depth placed, from _____ feet to _____ feet for each plug set. 6/11/79: Spotted cement plugs as follows:
75 sx 4875-5100'
60 sx 360-528'
10 sx 0-40'
5 sx in Rat Hole
Released rig at 1 p.m. 6/11/79. Cut off casing 4' below GL and welded on cap with well name and date.

(If additional description is necessary, use BACK of this sheet)

Name of Plugging Contractor _____

STATE OF Oklahoma COUNTY OF Oklahoma, ss.

H. E. Massey (employee of owner) or (owner or operator)
of the above-described well, being first duly sworn on oath, says: That I have knowledge of the facts, statements, and matters herein contained and the log of the above-described well as filed and that the same are true and correct. So help me God.

(Signature) H. E. Massey H. E. Massey
3545 N. W. 58th Street, Okla. City, Okla. 73112 Operations Manager
(Address)

SUBSCRIBED AND SWORN TO before me this 13th day of June, 19 79

Joyce S. Darter
Joyce S. Darter Notary Public.

My commission expires 6/10/80

RECEIVED
STATE CORPORATION COMMISSION
JUN 15 1979
CONSERVATION DIVISION
Wichita, Kansas

FORMATION, TESTING AND COMPLETION RECORD

15-025-20288-0000

Show Drill Stem Tests,
Well Stimulation and
Production Tests

Formation	Top	Bottom	
Soil, Sand & Clay	0	480	DST #1 Marmaton 4064-5224
Red Bed	480	1784	
Anhydrite & Shale	1784	2721	DST #2 Cherokee Miss. 5166-5224
Lime and Shale	2721	5274	
T.D.		5274	

RECEIVED
STATE CORPORATE COMMISSION
JUN 15 1979
CONSERVATION COMMISSION
Wichita, Kansas