

15-191-00618-0000

STATE OF KANSAS
STATE CORPORATION COMMISSION

Give All Information Completely
Make Required Affidavit
Mail or Deliver Report to:
Conservation Division
State Corporation Commission
800 Bittling Building
Wichita, Kansas

WELL PLUGGING RECORD

Sumner County, Sec. 34 Twp. 30S Rge. 1W (E) (W)

Location as "NE/CNW/SW" or footage from lines 600' from N.L. 440' from E.L.
Lease Owner: Morris Mizel Oil Producer

Lease Name: Nixon Well No. 1

Office Address: Kennedy Bldg. Tulsa, Oklahoma

Character of Well (completed as Oil, Gas or Dry Hole): Dry Hole

Date well completed: January 5, 19 54

Application for plugging filed: January 5, 19 54

Application for plugging approved: January 5, 19 54


Plugging commenced: January 5, 19 54

Plugging completed: January 5, 19 54

Reason for abandonment of well or producing formation:

If a producing well is abandoned, date of last production: 19

Was permission obtained from the Conservation Division or its agents before plugging was commenced? Yes

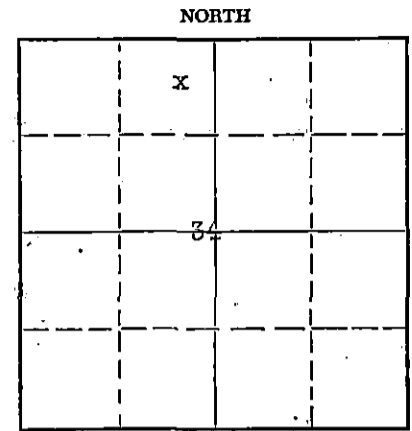

Locate well correctly on above Section Flat

Name of Conservation Agent who supervised plugging of this well: W.G. Buffington Arkansas City, Kansas

Producing formation: Depth to top: Bottom: Total Depth of Well: 4064' Feet

Show depth and thickness of all water, oil and gas formations.

OIL, GAS OR WATER RECORDS

CASING RECORD

FORMATION	CONTENT	FROM	TO	SIZE	PUT IN	PULLED OUT
				10 3/4"	334'	None

Describe in detail the manner in which the well was plugged, indicating where the mud fluid was placed and the method or methods used in introducing it into the hole. If cement or other plugs were used, state the character of same and depth placed, from feet to feet for each plug set.

Filled hole with heavy Rotary Mud from 4064' to 335', then pushed wooden plug to 335', then placed 15 sacks of cement on top of plug, then filled with heavy mud to within 25' of top of hole, then placed Haliburton plug at 25', then placed 10 sacks of cement on top of plug, filling to top of hole, cut surface pipe off below plow depth.

1-11-54

(If additional description is necessary, use BACK of this sheet)

Name of Plugging Contractor: H.J. Uhl Drilling Company
Address: 5650 North Broadway Wichita, Kansas

STATE OF Kansas, COUNTY OF Sedgwick, ss.
Fred Maddox (employee of owner) or (owner or operator) of the above-described well, being first duly sworn on oath, says: That I have knowledge of the facts, statements, and matters herein contained and the log of the above-described well as filed and that the same are true and correct. So help me God.


(Signature) Fred Maddox

5650 North Broadway (Address)

SUBSCRIBED AND SWORN TO before me this 6th day of January, 19 54

My commission expires June 4, 19 56

Notary Public

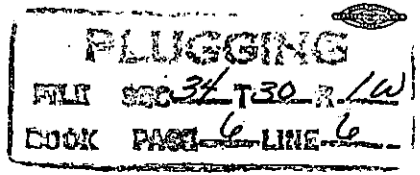

24-7368-S 3-53-20M

CERTIFIED WELL LOG

Owner: Morris Hize Oil Producer
 Kennedy Bldg.
 Tulsa, Oklahoma
 Commenced: 12-11-53
 Completed: 1-5-54

Contractor: H.J. Uhl Drlg. Co.
 6650 North Broadway
 Wichita, Kansas
 #1 Nixon 600' from N.L.
 440' from M.L.
 W 1/2 Sec. 34-30S-1W
 Sumner Co. Kansas
 Casing Record: 10 3/4"
 Surface Pipe @ 334' W/
 300 sacks Cement.

FORMATION	FROM	TOO	FORMATION	FROM	TOO
Soil Shale & Shells	0'	85'	Shale & Lime	3165'	3165'
Shale & Shells	85'	365'	Lime	3165'	3190'
Lime & Shale	365'	845'	Lime & Shale	3190'	3315'
Shale & Shells	845'	1020'	Shale & Lime	3315'	3365'
Lime & Shale	1020'	1165'	Lime & Shale	3365'	3528'
Shale & Lime	1165'	1200'	Shale & Lime	3528'	3582'
Shale & Shells	1200'	1640'	Mississippi Lime	3582'	3946'
Lime & Shale	1640'	1895'	Lime & Shale	3946'	3965'
Lime	1895'	2260'	Sand	3965'	3993'
Lime & Shale	2260'	2345'	Sand & Shale	3993'	4048'
Lime	2345'	2415'	Sand	4048'	4055'
Lime & Shale	2415'	2465'	Lime	4055'	4064'
Shale & Lime	2465'	2585'	Total Depth		4064'
Shale	2585'	2628'	D.A. Plugged		
Sand	2628'	2717'			
Shale	2717'	2730'			
Shale & Shells	2730'	2800'			
Shale	2800'	2940'			
Lime	2940'	3060'			
Broken Lime	3060'	3120'			
Lime	3120'	3152'			

H.J. Uhl Drlg. Co.
 By Fred Maddox

ACKNOWLEDGEMENT

STATE OF Kansas
) SS
 COUNTY OF Sedgwick

Before me, the undersigned, a Notary Public, within and for said County and State, on this 5th Day of January, 1954, personally appeared Fred Maddox to me personally known to be the identical person who executed the same and foregoing instrument and acknowledged to me that he executed the same as his free and voluntary act and deed for the uses and purposes therein set forth.

IN WITNESS WHEREOF, I have hereunto set my hand and official seal the day and year last above written.

My Commission Expires June 7, 1956
J. A. Nelson
 Notary Public

PLUGGING
 FILE SEC 34 T 30 S 1W
 BOOK 6 PAGE 6 LINE 6