

STATE OF KANSAS
STATE CORPORATION COMMISSION


Form CP-4

Give All Information Completely
Make Required Affidavit
Mail or Deliver Report to:
Conservation Division
State Corporation Commission
212 No. Market
Wichita, Kansas

WELL PLUGGING RECORD

Sumner County, Sec. 33 Twp. 30S Rge. 1 (E) W (W)
C NW SW

NORTH

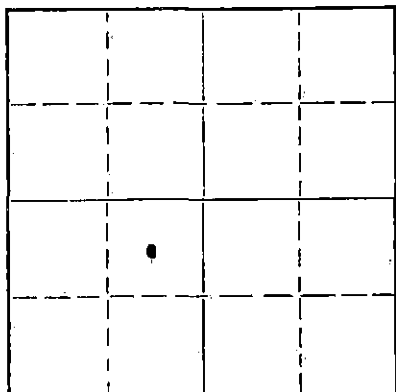

Locate well correctly on above Section Plat

Location as "NE/CNW/SW" or footage from lines
Lease Owner Charles R. King
Lease Name Blumenshine Well No. #1
Office Address 1527 Wichita Plaza, Wichita, Kansas
Character of Well (completed as Oil, Gas or Dry Hole) Dry Hole
Date well completed 11-9 1966
Application for plugging filed 11-9 1966
Application for plugging approved 11-9 1966
Plugging commenced 11-9 1966
Plugging completed 11-9 1966
Reason for abandonment of well or producing formation Dry Hole

If a producing well is abandoned, date of last production 19
Was permission obtained from the Conservation Division or its agents before plugging was commenced? Yes

Name of Conservation Agent who supervised plugging of this well Howard Hess, Winfield, Kansas
Producing formation _____ Depth to top _____ Bottom _____ Total Depth of Well 4010 Feet
Show depth and thickness of all water, oil and gas formations.

OIL, GAS OR WATER RECORDS

CASING RECORD

FORMATION	CONTENT	FROM	TO	SIZE	PUT IN	PULLED OUT
Surface Pipe		-0--	327	8 5/8"	327	-0-

Describe in detail the manner in which the well was plugged, indicating where the mud fluid was placed and the method or methods used in introducing it into the hole. If cement or other plugs were used, state the character of same and depth placed, from _____ feet to _____ feet for each plug set.

Filled hole with heavy mud

#1 plug at 225' w/ 20sks. cement

#2 plug at 35' w/8 sks. cement

#3 plug in rat hole w/2sks. cement

RECEIVED
STATE CORPORATION COMMISSION
NOV 14 1966
CONSERVATION DIVISION
Wichita, Kansas

(If additional description is necessary, use BACK of this sheet)

Name of Plugging Contractor S & S Drilling Company
Address Box 645, Great Bend, Kansas 67530

STATE OF Kansas, COUNTY OF Barton, ss.
T. D. Sweetman (employee of owner) or (owner or operator) of the above-described well, being first duly sworn on oath, says: That I have knowledge of the facts, statements, and matters herein contained and the log of the above-described well as filed and that the same are true and correct. So help me God.

(Signature) T. D. Sweetman
Box 645, Great Bend, Kansas 67530
(Address)

SUBSCRIBED AND SWORN TO before me this 10th day of November, 1966

Reata L. Boyd
Notary Public.

My commission expires 5/9/67

WELL LOG
Blumenshine #1
C NW SW 33-30S-1W
Sumner County, Kansas

<u>FROM</u>	<u>TO</u>		<u>Formation Tops:</u>	
0	325	Shale & Lime		
325	1135	Lime & Shale	K.C.	2970'
1135	2700	Shale & Lime	Base K. C.	3705'
2700	2747	Sand	Marmaton	3279'
2747	2900	Shale	Cherokee	3473'
2900	3085	Shale & Lime	Mississippi	3607'
3085	3205	Lime	Kinderhook	3924'
3205	3350	Lime & Shale	Simpson-Sand	3978'
3350	3592	Shale & Lime	T. D.	4010'
3592	3935	Mississippi Lime		
3935	3978	Shale		
3978	3988	Simpson Sand		
3988	4010	Shale & Sand		
4010		Total Depth		

STATE OF KANSAS

COUNTY OF BARTON ss

T. D. Sweetman, Partner of S & S Drilling Company, being first duly sworn on oath says: That I have knowledge of the facts, statements and matters herein contained and the log of the above described well as filed and that the same are true and correct.

T. D. Sweetman
T. D. Sweetman

Subscribed and sworn before me this 10th day of November, 1966.

Heath S. Boyd
Notary Public Barton County

My Commission Expires 5/9/67