

15-191-30033-0000

50

STATE OF KANSAS  
STATE CORPORATION COMMISSION


Form CP-4

Give All Information Completely  
Make Required Affidavit  
Mail or Deliver Report to:  
Conservation Division  
State Corporation Commission  
211 No. Broadway  
Wichita, Kansas

WELL PLUGGING RECORD

31-30-1W

NORTH

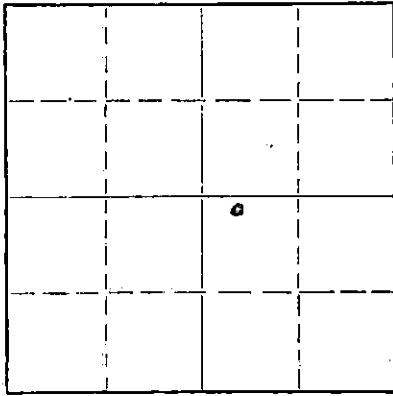

Locate well correctly on above  
Section Plat

Sumner County, Sec. 31 Twp. 30s Rge. 1w (E) (W)  
Location as "NE/CNW/SW" or footage from lines N/2-NW-SE  
Lease Owner Beardmore Drilling Company  
Lease Name Guldner Well No. #1  
Office Address 700 One Twenty Building, Wichita, Kansas  
Character of Well (completed as Oil, Gas or Dry Hole) Dry Hole  
Date well completed 6-19 19 65  
Application for plugging filed 6-19 19 65  
Application for plugging approved 6-19 19 65  
Plugging commenced 6-19 19 65  
Plugging completed 6-19 19 65  
Reason for abandonment of well or producing formation Dry Hole

If a producing well is abandoned, date of last production \_\_\_\_\_ 19\_\_\_\_  
Was permission obtained from the Conservation Division or its agents before plugging was commenced? Yes

Name of Conservation Agent who supervised plugging of this well Howard Hess, Winfield, Kansas  
Producing formation \_\_\_\_\_ Depth to top \_\_\_\_\_ Bottom \_\_\_\_\_ Total Depth of Well 4065 Feet  
Show depth and thickness of all water, oil and gas formations.

OIL, GAS OR WATER RECORDS

CASING RECORD

FORMATION	CONTENT	FROM	TO	SIZE	PUT IN	PULLED OUT

Describe in detail the manner in which the well was plugged, indicating where the mud fluid was placed and the method or methods used in introducing it into the hole. If cement or other plugs were used, state the character of same and depth placed, from \_\_\_\_\_ feet to \_\_\_\_\_ feet for each plug set.

15 sks cement @ 240' - 8 sks cement @ 40'  
2 sks cement in rat hole.

RECEIVED  
STATE CORPORATION COMMISSION

JUN 22 1965

CONSERVATION DIVISION  
Wichita, Kansas

(If additional description is necessary, use BACK of this sheet)

Name of Plugging Contractor German Drilling Company  
Address 502 Petroleum Building, Wichita, Kansas

STATE OF Kansas, COUNTY OF Sedgwick, ss.  
Harvey F. German (employee of owner) or (owner or operator) of the above-described well, being first duly sworn on oath, says: That I have knowledge of the facts, statements, and matters herein contained and the log of the above-described well as filed and that the same are true and correct. So help me God.

(Signature) Harvey F. German  
Harvey F. German  
502 Petroleum Bldg., Wichita, Kansas  
(Address)

SUBSCRIBED AND SWORN TO before me this 21st day of June, 19 65

My commission expires February 28th, 1968.

Geneva M. German  
Geneva M. German - Notary Public.

WELL LOG--Guldner #1

OPERATOR: Beardmore Drilling Company  
700 One Twenty Building  
Wichita, Kansas

RECEIVED  
STATE CORPORATION COMMISSION

LOCATION: N/2-NW-SE  
31-30s-1w  
Sumner County, Ks.

CONTRACTOR: German Drilling Company  
502 Petroleum Building  
Wichita, Kansas

JUN 22 1965

Farm: Guldner  
Date Commenced: 6-5-65  
Date Completed: 6-19-65

CONSERVATION DIVISION  
- Wichita, Kansas Well No. #1  
-  
- Rotary

From	To	Formation
0	40	Lime
40	225	Shale, lime
225	395	Lime, shale
395	409	Lime
409	510	Lime
510	740	Lime, shale
740	996	Lime, shale
996	1245	Lime
1245	1435	Shale, lime
1435	1690	Shale, lime
1690	1721	Lime, shale (Elmont)
1721	1770	Shale, lime
1770	2040	Shale, lime
2040	2183	Shale, lime
2183	2265	Lime, shale
2265	2445	Shale, lime
2445	2655	Shale, lime
2655	2778	Lime, shale
2778	2820	Sand, shale (Stallnaker)
2820	2936	Shale, lime
2936	3041	Shale, lime
3041	3116	Lime (Kansas City)
3116	3164	Lime (Kansas City)
3164	3250	Lime
3250	3288	Lime
3288	3375	Shale, lime
3375	3438	Lime, shale
3438	3522	Lime, shale
3522	3632	Lime, shale
3632	3680	Lime, shale
3680	3685	Lime, chert (Mississippi)
3685	3700	Lime
3700	3730	Lime
3730	3748	Lime
3748	3811	Lime
3811	3860	Lime
3860	3914	Lime
3914	4001	Lime
4001	4046	Lime
4046	4047	Lime
4047	4049	Shale
4049	4053	Shale
4053	4058	Sand
4058	4065	Sand
4065		TD

I hereby certify that the foregoing is a true and correct copy of the Well Log for the Guldner #1, drilled for the Beardmore Drilling Company and completed June 19th, 1965.

Surface: -----  
Production: -----

STATE OF KANSAS )  
                          ) ss.  
COUNTY OF SEDGWICK )

GERMAN DRILLING COMPANY

*Harvey F. German*  
Harvey F. German-Owner

Subscribed and sworn to, before the undersigned, a Notary Public, in and for County and State aforesaid, this twenty-first day of June, 1965.

*Geneva M. German*  
Geneva M. German

My commission expires February 28th, 1968.