

15-191-30005-0000

9


STATE OF KANSAS
STATE CORPORATION COMMISSION

Form CP-4

Give All Information Completely
Make Required Affidavit
Mail or Deliver Report to:
Conservation Division
State Corporation Commission
211 No. Broadway
Wichita, Kansas

WELL PLUGGING RECORD

NORTH

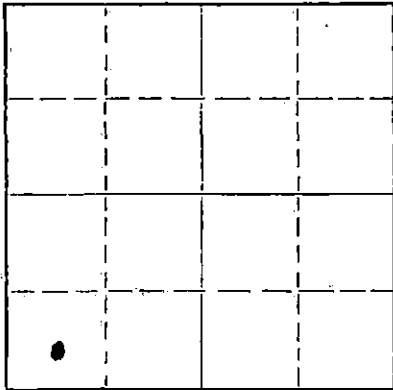

Locate well correctly on above
Section Plat

Sumner County, Sec. 31 Twp. 30s Rge. 1W (E) (W)
Location as "NE/CNWxSWx" or footage from lines C S/2 SW-SW
Lease Owner Beardmore Drilling Company
Lease Name Bates Well No. #1
Office Address 827 Beacon Building, Wichita, Kansas
Character of Well (completed as Oil, Gas or Dry Hole) Dry Hole
Date well completed 3-12 1965
Application for plugging filed 3-12 1965
Application for plugging approved 3-12 1965
Plugging commenced 3-12 1965
Plugging completed 3-12 1965
Reason for abandonment of well or producing formation Dry Hole

If a producing well is abandoned, date of last production 19
Was permission obtained from the Conservation Division or its agents before plugging was commenced? Yes

Name of Conservation Agent who supervised plugging of this well Howard Hess, Winfield, Kansas
Producing formation _____ Depth to top _____ Bottom _____ Total Depth of Well 3755 Feet
Show depth and thickness of all water, oil and gas formations.

OIL, GAS OR WATER RECORDS

CASING RECORD

FORMATION	CONTENT	FROM	TO	SIZE	PUT IN	PULLED OUT

Describe in detail the manner in which the well was plugged, indicating where the mud fluid was placed and the method or methods used in introducing it into the hole. If cement or other plugs were used, state the character of same and depth placed, from _____ feet to _____ feet for each plug set.

15 Sks. Cement @ 225' - 8 Sks. Cement @ 40' -
2 Sks. in Rat Hole.

RECEIVED
STATE CORPORATION COMMISSION

MAR 16 1965

CONSERVATION DIVISION
Wichita, Kansas

(If additional description is necessary, use BACK of this sheet)
Name of Plugging Contractor German Drilling Company
Address 502 Petroleum Building, Wichita, Kansas

STATE OF Kansas, COUNTY OF Sedgwick, ss.
Harvey F. German (employee of owner) or (owner or operator) of the above-described well, being first duly sworn on oath, says: That I have knowledge of the facts, statements, and matters herein contained and the log of the above-described well as filed and that the same are true and correct. So help me God.

(Signature) Harvey F. German
Harvey F. German
502 Petroleum Bldg., Wichita, Kansas
(Address)

SUBSCRIBED AND SWORN to before me this 15th day of March 19 65

My commission expires February 28th, 1968
Geneva M. German Notary Public.

WELL LOG--Bates #1

GP

OPERATOR: German Drilling Company
502 Petroleum Building
Wichita, Kansas.

LOCATION: C/S2 SW-SW
31-30s-1w
Sumner County
Kansas

CONTRACTOR: Beardmore Drilling Company
827 Beacon Building
Wichita, Kansas

RECEIVED
STATE CORPORATION COMMISSION
MAR 16 1965
CONSERVATION DIVISION
Wichita, Kansas

Farm: Bates
Date Commenced: 3-1-65
Date Completed: 3-11-65

Well No. #1

Rotary

From	To
0	95
95	415
415	420
420	428
428	735
735	915
915	1065
1065	1190
1190	1560
1560	1725
1725	1758
1758	1835
1835	1956
1956	2220
2220	2396
2396	2535
2535	2735
2735	2835
2835	2905
2905	3073
3073	3128
3128	3193
3193	3280
3280	3315
3315	3394
3394	3450
3450	3560
3560	3655
3655	3721
3721	3725
3725	3729
3729	3755

Formation:

Shale, lime
 Shale, lime
 Lime (Anhydrite)
 Lime
 Lime, shale
 Lime, shale
 Lime, shale
 Lime, shale
 Shale, lime
 Shale, lime
 Lime, shale (Elmont)
 Shale, lime
 Shale, lime
 Shale, lime
 Shale, lime
 Lime; shale
 Shale, lime
 Shale
 Shale
 Shale
 Lime (Kansas City)
 Lime
 Lime
 Lime
 Shale, lime
 Lime, shale
 Lime, shale
 Lime, shale
 Shale
 Shaley chert
 Chert, lime
 Mississippi
 Total Depth

I hereby certify that the foregoing is a true and correct copy of the Well Log for the Bates #1, drilled for the Beardmore Drilling Company and completed March 11th, 1965.

GERMAN DRILLING COMPANY

Surface: 420 8 5/8
Production: -----

Harvey F. German
Harvey F. German-Owner

STATE OF KANSAS }
 } ss.
COUNTY OF SEDGWICK }

Subscribed and sworn to, before the undersigned, a Notary Public, in and for County and State aforesaid, this fifteenth day of March, 1965.

Geneva M. German
Geneva M. German-Notary Public

My commission expires February 28th, 1968.