


WELL PLUGGING RECORD

Give All Information Completely
Make Required Affidavit
Mail or Deliver Report to:
Conservation Division
State Corporation Commission
212 North Market, Insurance Bldg.
Wichita, Kansas

NORTH

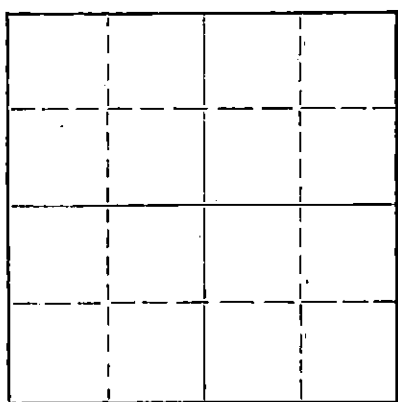

Locate well correctly on above
Section Plat

Sumner County. Sec. 8 Twp. 30S. Rge. (E) 2 (W)
Location as "NE/CNW/SW" or footage from lines NW NW SW
Lease Owner White & Ellis Drilling, Inc.
Lease Name B. L. Johnson Well No. 1
Office Address Box 448, El Dorado, Kansas
Character of Well (completed as Oil, Gas or Dry Hole) Dry Hole
Date well completed October 6 19 60
Application for plugging filed October 6 19 60
Application for plugging approved October 6 19 60
Plugging commenced October 6 19 60
Plugging completed October 6 19 60
Reason for abandonment of well or producing formation Dry Hole

If a producing well is abandoned, date of last production 19
Was permission obtained from the Conservation Division or its agents before plugging was commenced? Yes

Name of Conservation Agent who supervised plugging of this well Lee Guthrie
Producing formation Depth to top Bottom Total Depth of Well 3260 Feet
Show depth and thickness of all water, oil and gas formations.

OIL, GAS OR WATER RECORDS

CASING RECORD

FORMATION	CONTENT	FROM	TO	SIZE	PUT IN	PULLED OUT
				8 5/8	213'	None

Describe in detail the manner in which the well was plugged, indicating where the mud fluid was placed and the method or methods used in introducing it into the hole. If cement or other plugs were used, state the character of same and depth placed, from feet to feet for each plug set.

Hole filled with heavy rotary mud to 180 feet. Bridge at 180 feet with 15 sacks cement on bridge. Hole filled with heavy rotary mud to 35 feet. Bridge at 35 feet with 10 sacks cement on bridge. Rat hole filled with heavy rotary mud and capped with 2 sacks cement.

RECEIVED
STATE CORPORATION COMMISSION
OCT 11 1960
CONSERVATION DIVISION
Wichita, Kansas

(If additional description is necessary, use BACK of this sheet)
Name of Plugging Contractor White & Ellis Drilling, Inc.
Address Box 448 - El Dorado, Kansas

STATE OF Kansas COUNTY OF Butler ss.
Ernest Sifford, Employee of Contractor (employee of owner) of the above-described well, being first duly sworn on oath, says: That I have knowledge of the facts, statements, and matters herein contained and the log of the above-described well as filed and that the same are true and correct. So help me God.

(Signature) Ernest Sifford
Box 448 - El Dorado, Kansas
(Address)

SUBSCRIBED AND SWORN to before me this 10th day of October, 19 60
My commission expires September 26, 1964
L. B. Auer Notary Public.

15-191-00091-0000

Casing Record

8 5/8

213' Cemented
w/140 sacks

Location: NW 1/4

Section: 6-30S-2W

Sumner County, Kansas

Farm: B. L. Johnson #1

Well Owner: White & Ellis Drig., et al

Contractor: White & Ellis Drig, Inc.

Started: 9/28/60

Completed: 10/6/60

15-191-00091-00-00

T.D.	3260'
Kelly Bushing Measurement 5' above ground level.	
FORMATION	DEPTH
Sand	0-63
Sand & Shale	205
Lime & Shale	213
Shale & Lime stks.	310
Sand & Shale	465
Lime	1125
Shale & Lime stks.	1165
Lime & Shale	1415
sd. Shale	1465
Shale & Lime stks.	1510
Lime & Shale stks.	1820
Lime	1875
Shale	1950
Lime	2002
sd. Shale	2050
Lime	2190
Shale & Lime	2238
Shale, sticky	2276
Lime & Shale	2390
Lime	2458
Shale & Lime	2566
Lime w/Shale stks.	2740
Shale & Lime	2950
Shale	3056
Lime	3260

RECEIVED
STATE CORPORATION COMMISSION
OCT 11 1960
CONSERVATION DIVISION
Wichita, Kansas

TOPS

Topeka	2050
Kansas City	3056

Dry Hole
Plugged & Abandoned

STATE OF KANSAS)
) ss
COUNTY OF BUTLER)

I hereby certify that the foregoing is a true and correct copy of the Well Log for the B. L. Johnson #1 well completed October 6, 1960.

Howard E. Russell
Howard E. Russell, Vice-President

Subscribed and sworn to, before the undersigned, a Notary Public, in and for the County and State aforesaid, this 10th day of October, 1960.

S. B. Ames
Notary Public

My Commission Expires September 26, 1964.