

STATE CORPORATION COMMISSION OF KANSAS  
OIL & GAS CONSERVATION DIVISION  
WELL COMPLETION OR RECOMPLETION FORM  
ACO-1 WELL HISTORY  
DESCRIPTION OF WELL AND LEASE

Operator: License # 09736  
Name ..Dorchester Hugoton, Ltd.  
Address ..9696 Skillman Street  
Suite 320-LB42  
City/State/Zip ..Dallas, Texas 75243-8200

Purchaser ..Gastrak Corp.

Operator Contact Person ..Howard C. Wadsworth  
Phone ..(214) 739-2002

Contractor: License # 03363  
Name ..Service Drilling Co.  
Box 5320, Borger, TX 79007

Wellsite Geologist ..John Dannelley  
Phone ..(806) 353-2161

Designate Type of Completion  
 New Well  Re-Entry  Workover  
 Oil  SWD  Temp Abd  
 Gas  Inj  Delayed Comp.  
 Dry  Other (Core, Water Supply etc.)

If OWNED: old well info as follows:  
Operator ..  
Well Name ..  
Comp. Date .. Old Total Depth ..

WELL HISTORY


Drilling Method:  
 Mud Rotary  Air Rotary  Cable  
8/7/89 8/11/89 9/29/89  
Spud Date Date Reached TD Completion Date  
2950 2901  
Total Depth PBTD

Amount of Surface Pipe Set and Cemented at 623 feet  
Multiple Stage Cementing Collar Used?  Yes  No  
If yes, show depth set .. feet  
If alternate 2 completion, cement circulated  
from .. feet depth to .. w/ .. SX cmt  
Cement Company Name ..  
Invoice # ..  
A I I

API NO. 15-.....189-21,355-00-00  
County.....Stevens  
NW/4 SE/4 SE/4 Sec. 35. Twp. 34. Rge. 39...  East  
 West  
1250.. Ft North from Southeast Corner of Section  
1250.. Ft West from Southeast Corner of Section  
(Note: Locate well in section plat below)

Lease Name.....Rawlings Well #.....I-2  
Field Name.....Hugoton  
Producing Formation.....Chase  
Elevation: Ground.....3286.10 3295.6 KB.....

Section Plat

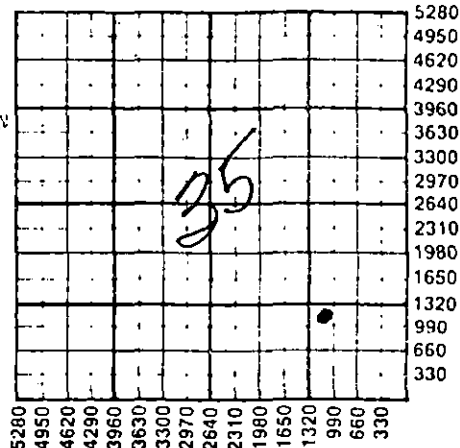

WATER SUPPLY INFORMATION

Disposition of Produced Water:  Disposal  
Docket # .....  Repressuring

Questions on this portion of the ACO-1 call:  
Water Resources Board (913) 296-3717

Source of Water:  
Division of Water Resources Permit #.....  
 Groundwater.....Ft North from Southeast Corner  
(Well) .....Ft West from Southeast Corner of  
Sec Twp Rge East West  
 Surface Water.....Ft North from Southeast Corner  
(Stream, pond etc).....Ft West from Southeast Corner  
Sec Twp Rge East West  
 Other (explain) ..Furnished by Drilling Contractor  
(purchased from city, R.W.D. #)

INSTRUCTIONS: This form shall be completed in triplicate and filed with the Kansas Corporation Commission, 200 Colorado Derby Building, Wichita, Kansas 67202, within 120 days of the spud date of any well. Rule 82-3-130, 82-3-107 and 82-3-106 apply. Information on side two of this form will be held confidential for a period of 12 months if requested in writing and submitted with the form. See rule 82-3-107 for confidentiality in excess of 12 months. One copy of all wireline logs and drillers time log shall be attached with this form. Submit CP-4 form with all plugged wells. Submit CP-111 form with all temporarily abandoned wells.

All requirements of the statutes, rules and regulations promulgated to regulate the oil and gas industry have been fully complied with and the statements herein are complete and correct to the best of my knowledge.

Signature ..  
Title ..Land and Lease Administrator Date 11/30/89

Subscribed and sworn to before me this 30th day of November 1989.  
Notary Public ..  
Date Commission Expires 7/11/93

K-C.C. OFFICE USE ONLY  
 Letter of Confidentiality Attached  
 Wireline Log Received  
 Drillers Timelog Received  
Distribution  
 KCC  SWD/Rep  NGPA  
 KGS  Plug  Other  
(Specify)