


STATE OF KANSAS
STATE CORPORATION COMMISSION

Give All Information Completely
Make Required Affidavit
Mail or Deliver Report to:
Conservation Division
State Corporation Commission
211 No. Broadway
Wichita, Kansas

WELL PLUGGING RECORD

Gomanche County, Sec. 24 Twp. 32 Rge. (E) 20 (W)

Location as "NE/CNW/SE" or footage from lines 0 NE SE
Lease Owner GRA, Inc.
Lease Name Cox "L" Well No. 1
Office Address Drawer C., Great Bend, Kansas
Character of Well (completed as Oil, Gas or Dry Hole) oil
Date well completed _____ 19____
Application for plugging filed March 6 1965
Application for plugging approved _____ 19____
Plugging commenced March 6 1965
Plugging completed March 15 1965
Reason for abandonment of well or producing formation depleted

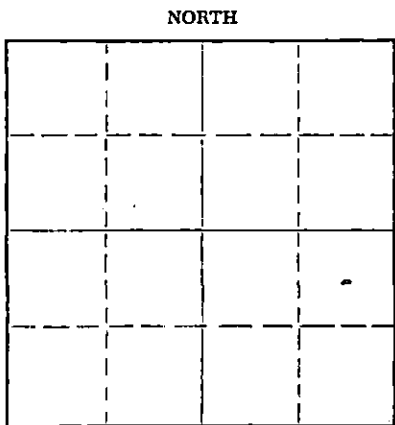

Locate well correctly on above
Section Plat

If a producing well is abandoned, date of last production _____ 19____
Was permission obtained from the Conservation Division or its agents before plugging was commenced? yes

Name of Conservation Agent who supervised plugging of this well Archie Elving
Producing formation _____ Depth to top _____ Bottom _____ Total Depth of Well 5250 Feet
Show depth and thickness of all water, oil and gas formations.

OIL, GAS OR WATER RECORDS

CASING RECORD

FORMATION	CONTENT	FROM	TO	SIZE	PUT IN	PULLED OUT
		0	547'	8 5/8"	547	none
		0	5240'	5 1/2"	5240	4358.60

Describe in detail the manner in which the well was plugged, indicating where the mud fluid was placed and the method or methods used in introducing it into the hole. If cement or other plugs were used, state the character of same and depth placed, from _____ feet to _____ feet for each plug set.

Pushed plug to 4600', set 10' rock bridge and dumped 5 sacks of cement.

Set wood bridge and dumped 10' of rock at 300'. Dumped 25 sacks of cement. Filled hole with mud and dirt to 40', set 10' rock and sand bridge and dumped 10 sacks of cement.

RECEIVED
STATE CORPORATION COMMISSION

APR 2 1965

CONSERVATION DIVISION
Wichita, Kansas

(If additional description is necessary, use BACK of this sheet)
Name of Plugging Contractor Pipe Pullers, Inc.
Address Box 486, Ellinwood, Kansas

STATE OF Kansas, COUNTY OF Barton, ss.
Dean Wells

(employee of owner) or (owner or operator) of the above-described well, being first duly sworn on oath, says: That I have knowledge of the facts, statements, and matters herein contained and the log of the above-described well as filed and that the same are true and correct. So help me God.

(Signature) Dean Wells

Ellinwood, Kansas

SUBSCRIBED AND SWORN to before me this 15 day of March, 1965

J. Rader
(Address)

My commission expires July 7, 1968

Notary Public.

15-033-00094-0000


WELL LOG BUREAU—KANSAS GEOLOGICAL SOCIETY
508 East Murdock, Wichita, Kansas

Company. D.G. HAMILTON
Farm- Cox No. 1

SEC. 24 T. 32 R. 20W
C NE SE

Total Depth. 5250'
Comm. 9-4-62 Comp. 9-24-62
Shot or Treated.
Contractor. Red Tiger Drilling
Issued. 5-11-63

County Comanche
KANSAS

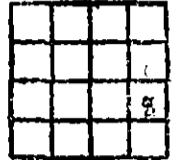

Elevation. 1923' DF

Production. 17. BOPD, 50% WTR

Figures Indicate Bottom of Formations.

sand	70
shale	115
sand	145
shale & shells	440
redbed & shale	515
Blane & lime	555
shale & shells	1420
Anhydrite	1425
Shale & shells	1985
Anhydrite	2035
shale & shells	2100
shale & lime	3564
lime	3675
lime & shale	4450
lime	4494
lime & shale	4500
lime	5250
Total Depth	

TOPS: SAMPLE	
Anhydrite	515
Herington	2360
Krider	2401
Winfield	2464
Ft. Riley	2550
Elgin Sand	4091
Heebner	4200
Douglas	4292
Brown Lime	4386
Lansing/Kansas City	4418
Base Kansas City	4734
Mississippian	5097

RECEIVED
STATE CORPORATION COMMISSION

FEB 22 1966

CONSERVATION DIVISION
Wichita, Kansas