


STATE OF KANSAS  
STATE CORPORATION COMMISSION

Give All Information Completely  
Make Required Affidavit  
Mail or Deliver Report to:  
Conservation Division  
State Corporation Commission  
212 North Market, Insurance Bldg.  
Wichita, Kansas

**WELL PLUGGING RECORD**

Meade County, Sec. 35 Twp. 34S Rge. (E) 29 (W)

Location as "NE/CNW/SW" or footage from lines 900' from EL & 500' from NL NW/4  
Lease Owner Humble Oil & Rfg. Co., Carter Division  
Lease Name Adams Unit "B" Well No. 1  
Office Address Box 786, Great Bend, Kansas  
Character of Well (completed as Oil, Gas or Dry Hole) Dry Hole  
Date well completed 4-9 19 60  
Application for plugging filed 4-21 19 60  
Application for plugging approved 4-25 19 60  
Plugging commenced 4-8 19 60  
Plugging completed 4-9 19 60  
Reason for abandonment of well or producing formation Drilled D & A

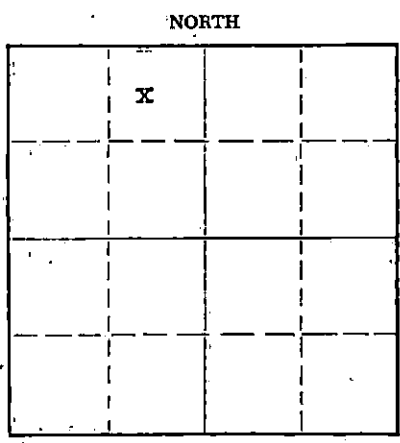

If a producing well is abandoned, date of last production 19  
Was permission obtained from the Conservation Division or its agents before plugging was commenced? Yes

Name of Conservation Agent who supervised plugging of this well Mr. Bill Lackamp  
Producing formation Depth to top Bottom Total Depth of Well 4605 Feet  
Show depth and thickness of all water, oil and gas formations.

OIL, GAS OR WATER RECORDS

CASING RECORD

FORMATION	CONTENT	FROM	TO	SIZE	PUT IN	PULLED OUT
				8-5/8"	1388'	0

Describe in detail the manner in which the well was plugged, indicating where the mud fluid was placed and the method or methods used in introducing it into the hole. If cement or other plugs were used, state the character of same and depth placed, from feet to feet for each plug set.

Filled hole with rotary mud to 550'. Set Howco wooden plug @ 550' w/20 sax common cement. Mud up to 120' and set Howco plug @ 120' w/20 sax common cement. Mud up to 35'. Set Howco plug @ 35' w/10 sax cement. Cement to 3' below ground level.

RECEIVED  
STATE CORPORATION COMMISSION  
JUN 13 1960  
CONSERVATION DIVISION  
Wichita, Kansas

(If additional description is necessary, use BACK of this sheet)  
Name of Plugging Contractor Moran Bros., Inc.  
Address Wichita Falls, Texas

STATE OF KANSAS, COUNTY OF BARTON, ss.  
I, Thomas R. Smith (employee of owner) or (owner or operator) of the above-described well, being first duly sworn on oath, says: That I have knowledge of the facts, statements, and matters herein contained and the log of the above-described well as filed and that the same are true and correct. So help me God.

(Signature) Thomas R. Smith  
THOMAS R. SMITH, District Engineer  
Box 786, Great Bend, Kansas  
(Address)

Subscribed and Sworn to before me this 10th day of June, 19 60

Notary Public  
My commission expires 5-4-1961




15-119-10263-0000

**Driller's Log**  
**Humble Oil and Refining Company**  
**Carter Division**  
**ADAMS "B" UNIT NO. 1**  
**Sec. 35, T34S, R29W**  
**Meade County, Kansas**

<u>Formation</u>	<u>From</u>	<u>To</u>
Surface clay and sand	0'	120'
Red bed	120'	990'
Red bed and shale	990'	1400'
Shale and lime	1400'	1967'
Anhydrite and lime	1967'	2120'
Shale and anhydrite	2120'	2604'
Anhydrite	2604'	2700'
Dolomite and shale	2700'	3031'
Lime and shale	3031'	3458'
Lime	3458'	3570'
Lime and chalk	3570'	3654'
Lime	3654'	3733'
Lime and shale	3733'	4230'
Shale and lime	4230'	4385'
Lime and shale	4385'	4505'
Lime	4505'	4510'
Lime and shale	4510'	4605' TD-SLM

Certified True and Correct

MORAN BROS., INC.

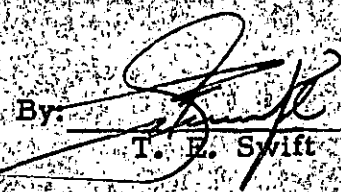By:   
 T. E. Swift

**RECEIVED**  
 OIL AND GAS CORPORATION COMMISSION  
 APR 25 1960  
 CONSERVATION DIVISION  
 Wichita, Kansas

TES/crb