


15-119-00064-0000

STATE OF KANSAS
STATE CORPORATION COMMISSION

Give All Information Completely
Make Required Affidavit
Mail or Deliver Report to:
Conservation Division
State Corporation Commission
211 No. Broadway
Wichita, Kansas

WELL PLUGGING RECORD

T 34S NORTH R 29W

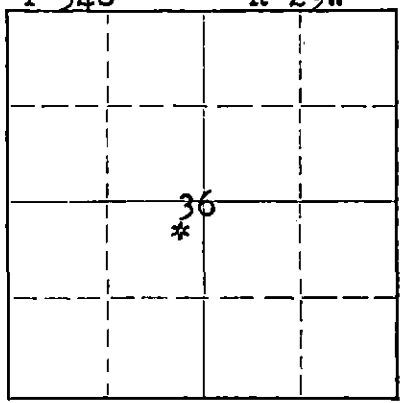

Locate well correctly on above
Section Plat

Meade County, Sec. 36 Twp. 34S Rge. 29W (E) (W)

Location as "NE/CNW/SW" or footage from lines NE NE SW
Lease Owner Carter Oil Company
Lease Name Adams Unit Well No. 1
Office Address Box 786 - Great Bend, Kansas
Character of Well (completed as Oil, Gas or Dry Hole) Dry
Date well completed May 1 19 57
Application for plugging filed May 3, 19 57
Application for plugging approved May 6, 19 57
Plugging commenced May 10 19 57
Plugging completed May 16 19 57
Reason for abandonment of well or producing formation Dry hole

If a producing well is abandoned, date of last production _____ 19 ____
Was permission obtained from the Conservation Division or its agents before plugging was commenced? Yes

Name of Conservation Agent who supervised plugging of this well Merle Rives
Producing formation - Depth to top - Bottom - Total Depth of Well 6309 Feet
Show depth and thickness of all water, oil and gas formations.

OIL, GAS OR WATER RECORDS

CASING RECORD

FORMATION	CONTENT	FROM	TO	SIZE	PUT IN	PULLED OUT
Morrow Fmn	dry	5917(-31)	110	8-5/8"	2465'	None
Morrow Sand	"	5940 (-34)	33	5-1/2"	6168'	5195'
Chester Lime	"	6030 (-35)	23			
Chester Poros.	"	6110. (-36)	03			
TD		6309				
				Hole plugged back to 6100' and casing perforated from 5942' to 5951'.		

Describe in detail the manner in which the well was plugged, indicating where the mud fluid was placed and the method or methods used in introducing it into the hole. If cement or other plugs were used, state the character of same and depth placed, from _____ feet to _____ feet for each plug set.

Filled the hole with sand from 6100' to 5940' and ran 5 sacks of cement. Pulled casing up to 2500' and circulated the hole with mud. Bailed mud to 600', set a 10' rock bridge and ran 25 sacks of cement. Mudded the hole to 35', set a 10' rock bridge and ran 10 sacks of cement to the base of the cellar. Plugging completed.

(If additional description is necessary, use BACK of this sheet)
Name of Plugging Contractor West Supply Co., Inc.
Address Chase, Kansas

STATE OF KANSAS, COUNTY OF BARTON, ss.
Hugh H. Goerner (employee of owner) or District Superintendent of the above-described well, being first duly sworn on oath, says: That I have knowledge of the facts, statements, and matters herein contained and the log of the above-described well as filed and that the same are true and correct. So help me God.

(Signature) Hugh H. Goerner
Hugh H. Goerner, District Superintendent
Box 786, Great Bend, Kansas
(Address)

SUBSCRIBED AND SWORN TO before me this 1st day of June, 1957

My commission expires August 19, 1957

Wm. H. Knisley
Wm. H. Knisley, Notary Public.

RECEIVED
STATE CORPORATION COMMISSION

JUN 4 X 1957
CONSERVATION DIVISION
Wichita, Kansas

(by)

PLUGGING
FILE SEC 36 T 34 R 29W
BOOK PAGE 10 LINE 43

15-119-00064-0000

WELL LOG

COMPANY CARTER OIL COMPANY

SEC. 36 T. 34S R. 29W

FARM ADAMS

NO. UNIT #1

LOC. NE, NE, SW


TOTAL DEPTH 6309'

COUNTY Meade Co., Kansas

COMM. February 28, 1957

COMP. April 2, 1957

CONTRACTOR GARVEY DRILLING COMPANY

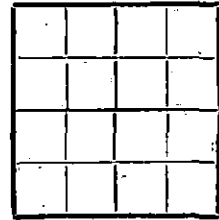

CASING 8 5/8" @ 2464' W/1475 sax.
5 1/2" @ 6189' W/200 sax.

ELEVATION 2507' DF

PRODUCTION

FIGURES INDICATE BOTTOM OF FORMATIONS

40	Clay & sand
150	Yellow clay
550	Red bed & sand
1000	Red bed, gyp & sand
1366	Red bed, sand & streaks anhydrite
1500	Red bed & gyp
1860	Red bed & shale
2117	Lime & red bed
2300	Lime & shale
2466	Anhydrite
2477	Lime
2600	Anhydrite
3204	Lime & shale
3349	Lime
4110	Shale & lime
4315	Shale
4458	Shale & shells
4630	Lime & shale
4675	Lime
4770	Lime & shale
5234	Lime
5290	Chalky lime
5610	Lime
5776	Lime & shale
5807	Lime
5890	Lime & shale
5970	Lime
6070	Lime & sand
6309	Lime & shale
6309	T. D.

PLUGGING
 FILE SEC. 36 T. 34 R. 29W
 BOOK PAGE 10 LINE 43

RECEIVED
 STATE CORPORATION COMMISSION

MAY 4 - 1957

CONSERVATION DIVISION
 Wichita, Kansas

State of KANSAS }
 County of BARTON } ss:

I, Verne A. Morris of Garvey Drilling Co.

upon oath state that the above and foregoing is a true and correct copy of the log of the #1 Adams Unit well

Verne A. Morris

Subscribed and sworn to before me this 11th day of April 19 57

My Commission Expires: November 12, 1958

Bransburg
 NOTARY PUBLIC