

15-191-10250000

69

STATE OF KANSAS
STATE CORPORATION COMMISSION

Form CP-4

Give All Information Completely
Make Required Affidavit
Mail or Deliver Report to:
Conservation Division
State Corporation Commission
212 No. Market
Wichita, Kansas

WELL PLUGGING RECORD

Summer County. Sec. 4 Twp. 32 Rge. 1 W (W)

Location as "NE/CNW/SW" or footage from lines NW NW NE

Lease Owner C.R.A., Inc.

Lease Name Wellington Unit Well No. 97 WSW

Office Address Box 98 Wellington, Kansas

Character of Well (completed as Oil, Gas or Dry Hole) Water Supply Well

Date well completed 6-7-37 19

Application for plugging filed 3-10-67 19

Application for plugging approved 3-13-67 19


Plugging commenced 4-26-67 19

Plugging completed 4-28-67 19

Reason for abandonment of well or producing formation

If a producing well is abandoned, date of last production 19

Was permission obtained from the Conservation Division or its agents before plugging was commenced? yes

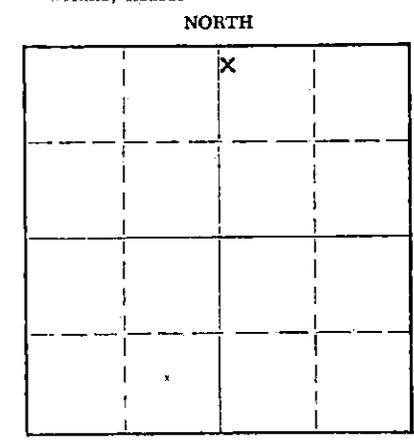

Locate well correctly on above Section Plat

Name of Conservation Agent who supervised plugging of this well Howard Hess

Producing formation Depth to top Bottom Total Depth of Well 3690 Feet

Show depth and thickness of all water, oil and gas formations.

OIL, GAS OR WATER RECORDS

CASING RECORD

FORMATION	CONTENT	FROM	TO	SIZE	PUT IN	PULLED OUT
				7"	3650'	1325'

Describe in detail the manner in which the well was plugged, indicating where the mud fluid was placed and the method or methods used in introducing it into the hole. If cement or other plugs were used, state the character of same and depth placed, from feet to feet for each plug set.

Set chat bridge from 3625' to 3615' and dump 4 sacks of cement

Set 10' chat bridge from 950' to 940' and dump 4 sacks of cement

Set 15' rock bridge from 240' to 225' and dump 5 1/2 cubic yards of ready mix concrete

RECEIVED
STATE CORPORATION COMMISSION

MAY 12 1967

CONSERVATION DIVISION
WICHITA, KANSAS

(If additional description is necessary, use BACK of this sheet)

Name of Plugging Contractor Flint Engineering and Const. Co.
Address 2375 W. Central El Dorado, Kansas

STATE OF Kansas, COUNTY OF Butler, ss.

(employee of owner) or (owner or operator) of the above-described well, being first duly sworn on oath, says: That I have knowledge of the facts, statements, and matters herein contained and the log of the above-described well as filed and that the same are true and correct. So help me God.

(Signature) *Ronald R. Hanson*

(Address)

SUBSCRIBED AND SWORN TO before me this 9 day of May, 19 67

My commission expires Sept. 27, 1967

Ronald R. Hanson

Notary Public.

15-191-10250-0910
WU 910 R

OK

ELEVATION—1254

FORMATION	DEPTH	SUB-SEA	THICK	SOURCE
Top Mississippian ls.	3650	-2396		
T.D.	3690	-2436		

OPERATOR—Stalbar Dewar Oil
 FARM—Rothrock NO. 4
 LOCATION—NW-NW-NE
 FOOTAGE
 S. T. R. (SUR.) S. 4, T. 32S, R. 1W.
 CO.-PA. Sumner
 STATE Kansas
 AREA Wellington Field

CASING RECORD—
 7" at 3650

DATE COMMENCED—5-12-37

DATE COMPLETED—6-7-37

PRODUCTION FORMATION—
 Mississippian ls.

INITIAL PRODUCTION—1565 b.o.

REMARKS—Acidized

Penetrated 40' Mississippian ls.

RECEIVED
 STATE CONSERVATION COMMISSION
 MAR 12 1967
 CONSERVATION DIVISION
 Wichita, Kansas