


Give All Information Completely
Make Required Affidavit
Mail or Deliver Report to:
Conservation Division
State Corporation Commission
212 North Market, Insurance Bldg.
Wichita, Kansas

WELL PLUGGING RECORD

NORTH

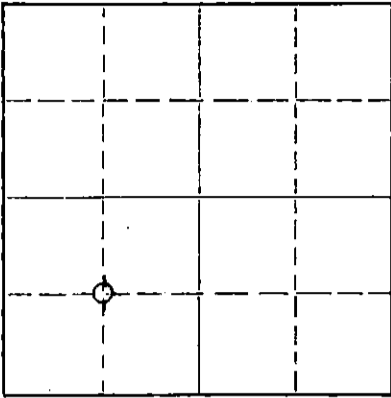

Locate well correctly on above
Section Plat

Stevens County, Sec. 15 Twp. 34S Rge. 38 (E) (W)
Location as "NE/CNW/SW" or footage from lines C SW
Lease Owner Anadarko Production Company
Lease Name Kelley Well No. "B" 1-15
Office Address P. O. Box 351, Liberal, Kansas
Character of Well (completed as Oil, Gas or Dry Hole) Junked Hole
Date well completed --- 19
Application for plugging filed September 26 19 60
Application for plugging approved Verbal approval by Mr. Lackamp 19
Plugging commenced September 27 19 60
Plugging completed September 27 19 60
Reason for abandonment of well or producing formation Junked Hole
If a producing well is abandoned, date of last production --- 19
Was permission obtained from the Conservation Division or its agents before plugging was commenced? yes

Name of Conservation Agent who supervised plugging of this well Mr. Lackamp
Producing formation _____ Depth to top _____ Bottom _____ Total Depth of Well 1,442 Feet
Show depth and thickness of all water, oil and gas formations.

OIL, GAS OR WATER RECORDS

CASING RECORD

FORMATION	CONTENT	FROM	TO	SIZE	PUT IN	PULLED OUT
			NONE			NONE

Describe in detail the manner in which the well was plugged, indicating where the mud fluid was placed and the method or methods used in introducing it into the hole. If cement or other plugs were used, state the character of same and depth placed, from _____ feet to _____ feet for each plug set.

Set McCullough open hole plug at 500'. Spotted 100 sacks of cement from 500' to 460'. Spotted 25 sacks of cement at 460'. Set bridge plug at depth of 50' and spotted 25 sacks cement. Top of plug 12 feet from surface.

RECEIVED
STATE CORPORATION COMMISSION
OCT 4 1960
CONSERVATION DIVISION
Wichita, Kansas

(If additional description is necessary, use BACK of this sheet)
Name of Plugging Contractor Schafer Drilling Company
Address P. O. Box 8837, Oklahoma City, Oklahoma

STATE OF Kansas, COUNTY OF Seward, ss.
I, R. L. O'Shields (employee of owner) or (owner/contractor) of the above-described well, being first duly sworn on oath, says: That I have knowledge of the facts, statements, and matters herein contained and the log of the above-described well as filed and that the same are true and correct. So help me God.

(Signature) R. L. O'Shields, Manager, Drilling & Production
P. O. Box 351, Liberal, Kansas (Address)

SUBSCRIBED AND SWORN TO before me this 28th day of September, 1960

My Commission Expires December 8, 1963

My commission expires _____

Patricia Jackson Notary Public.

INVOICED

DATE 6/19/62
INV. NO. 5199-W

15-189-00030-0000

DRILLER'S LOG

WELL NAME: Kelley "B" 1-15 ; COMPANY OPERATING: Anadarko Production Company
 ADDRESS of COMPANY: Box 351, Liberal, Kansas

WELL LOCATION: $\frac{1}{4}$ C $\frac{1}{4}$ SW $\frac{1}{4}$,
1,320 ft. North of South line,
1,320 ft. East of West line; Sec. 15, Twp. 34S, Rge. 28W, Stevens County, Kansas

DRILLING STARTED September 18, 1960; DRILLING COMPLETED September 27, 1960
 WELL COMPLETED ---, 19---; WELL CONNECTED ---, 19---
Junked

ELEVATION: 3231.62 ft. Ground Level; CHARACTER OF WELL (Oil, Gas, or Dry Hole) Hole

OIL OR GAS SANDS OR ZONES - PERFORATIONS - ACIDIZING AND FRACTURING INFORMATION					
Name	From	To	No. of Shots	Gallons Used	Kind Used
			None		

CASING RECORD

Size	Amount Set	Sacks of Cement	Amount Pulled
	None		

FORMATION RECORD

Formation	Top	Bottom	Formation	Top	Bottom
Sand, Shells, & Red Bed	0	635			
Red Bed, Shells, & Sand	635	1127			
Red Bed, Shells, & Sand	1127	1384			
Sand	1384	1442			
Total Depth	1442				

NOV 17 1960
 STATE COMMISSION
 CONSERVATION DIVISION
 Wichita, Kansas

RESULTS of INITIAL PRODUCTION TEST: _____