

STATE OF KANSAS
STATE CORPORATION COMMISSION

WELL PLUGGING RECORD

Give All Information Completely
Make Required Affidavit
Mail or Deliver Report to
Conservation Division
State Corporation Comm.
245 North Water
Wichita, KS 67202

Morton County, Sec. 2 Twp. 32 Rge. 41 E/W
Location as "NE/CNW 1/4 SW 1/4" or footage from lines
C NE

Lease Owner Kennedy & Mitchell, Inc.
Lease Name Thrash Well No. 29-485
Office Address Box 1578, Liberal, KS 67901


Character of Well (Completed as Oil, Gas or Dry Hole)
dry hole

Date Well completed January 10 19 80
Application for plugging filed January 13 19 80
Application for plugging approved 19
Plugging commenced January 13 19 80
Plugging completed January 13 19 80

Reason for abandonment of well or producing formation
dry
If a producing well is abandoned, date of last production
19

Was permission obtained from the Conservation Division or
its agents before plugging was commenced? Yes

Name of Conservation Agent who supervised plugging of this well Clarence Thomas Jr.
Producing formation _____ Depth to top _____ Bottom _____ Total Depth of Well 5500'
Show depth and thickness of all water, oil and gas formations.

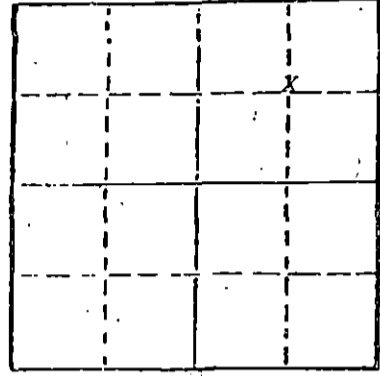

OIL, GAS OR WATER RECORDS

CASING RECORD

FORMATION	CONTENT	FROM	TO	SIZE	PUT IN	PULLED OUT
				8 5/8"	1514'	none

Describe in detail the manner in which the well was plugged, indicating where the mud fluid was placed and the method or methods used in introducing it into the hold. If cement or other plugs were used, state the character of same and depth placed, from _____ feet to _____ feet for each plug set. Plugged well as follows:

25 sacks @ 3200'; 45 sacks @ 2800'; 35 sacks @ 1500';
25 sacks @ 700'; 10 sacks @ 40'-0'; 5 sacks rathole
job complete @ 2:55PM on 1-13-80

RECEIVED
STATE CORPORATION COMMISSION

JAN 16 1980

CONSERVATION DIVISION
Wichita, Kansas

(If additional description is necessary, use BACK of this sheet)

Name of Plugging Contractor Dowell, Ulysses

STATE OF Kansas COUNTY OF Seward, ss.
Ned E. Lowry, Agent (employee of owner) or (owner or operator)


of the above-described well, being first duly sworn on oath, says: That I have knowledge of the facts, statements, and matters herein contained and the log of the above-described well as filed and that the same are true and correct. So help me God.

(Signature) Ned E Lowry
Box 1578, Liberal, KS 67901
(Address)

SUBSCRIBED AND SWORN TO before me this 15th day of January, 1980

Denise Geist
Notary Public.

My commission expires February 26, 1983

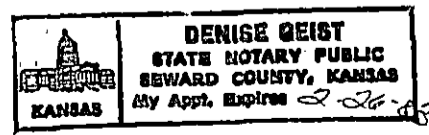

15-129-20420-0000

IMPORTANT
Kans. Geo. Survey request
samples on this well.

KANSAS DRILLERS LOG

S. 2 T. 32 R. 41 ^X/_W
Loc. C NE

API No. 15 — 129 — 20,420
County Number

County Morton

Operator
Kennedy & Mitchell, Inc.

Address
P. O. Box 1578 Liberal, Kansas 67901

Well No. #29-485 Lease Name Thrash

Footage Location
1320 feet from (N) XXY line 1320 feet from (E) XXY line

Principal Contractor Gabbert & Jones Geologist

Spud Date 12-20-79 Total Depth 5500' P.B.T.D.

Date Completed 1-14-80 Oil Purchaser

640 Acres
N

Locate well correctly

Elev.: Gr. 3368'

DF 3375' KB 3377'

CASING RECORD

Report of all strings set— surface, intermediate, production, etc.

Purpose of string	Size hole drilled	Size casing set (in O.D.)	Weight lbs/ft.	Setting depth	Type cement	Sacks	Type and percent additives
Surface	12 1/2"	8 5/8"	24#	1514'	65/35 poz	600	6% gel, 12 1/2# Kolite 2% cc
					Class H	150	3% cc

LINER RECORD

PERFORATION RECORD

Top, ft.	Bottom, ft.	Sacks cement	Shots per ft.	Size & type	Depth interval

Size	Setting depth	Packer set at

ACID, FRACTURE, SHOT, CEMENT SQUEEZE RECORD

Amount and kind of material used	Depth interval treated

RECEIVED
STATE CORPORATION COMMISSION
JAN 18 1980
CONSERVATION DIVISION
Wichita, Kansas

INITIAL PRODUCTION

Date of first production		Producing method (flowing, pumping, gas lift, etc.)			
RATE OF PRODUCTION PER 24 HOURS	Oil	Gas	Water	Gas-oil ratio	
	bbis.	MCF	bbis.	CFPB	
Disposition of gas (vented, used on lease or sold)			Producing interval (s)		

INSTRUCTIONS: As provided in KCC Rule 82-2-125, within 90 days after completion of a well, one completed copy of this Drillers Log shall be transmitted to the State Geological Survey of Kansas, 4150 Monroe Street, Wichita, Kansas 67209. Copies of this form are available from the Conservation Division, State Corporation Commission, 3830 So. Meridian (P.O. Box 17027), Wichita, Kansas 66217. Phone AC 316-522-2206. If confidential custody is desired, please note Rule 82-2-125. Drillers Logs will be on open file in the Oil and Gas Division, State Geological Survey of Kansas, Lawrence, Kansas 66044.

Operator

Kennedy & Mitchell, Inc.

DESIGNATE TYPE OF COMP.: OIL, GAS,
DRY HOLE, SWDW, ETC.:

Dry Hole

Well No.

29-485

Lease Name

Thrash

S 2 T 32 R 41 ^W

WELL LOG

Show all important zones of porosity and contents thereof; cored intervals, and all drill-stem tests, including depth interval tested, cushion used, time tool open, flowing and shut-in pressures, and recoveries.

SHOW GEOLOGICAL MARKERS, LOGS RUN,
OR OTHER DESCRIPTIVE INFORMATION.

FORMATION DESCRIPTION, CONTENTS, ETC.	TOP	BOTTOM	NAME	DEPTH
Redbed	0	1515		
Shale & Lime	1515	3050		
Lime & Shale	3050	5500TD		

USE ADDITIONAL SHEETS, IF NECESSARY, TO COMPLETE WELL RECORD.

Date Received

Ned E. Leary
Signature

Kennedy & Mitchell, Inc. Agent

Title

January 16, 1980

Date