

15-129-00262-0000

STATE OF KANSAS
STATE CORPORATION COMMISSION


WELL PLUGGING RECORD

Give All Information Completely
Make Required Affidavit
Mail or Deliver Report to:
Conservation Division
State Corporation Commission
800 Bittling Building
Wichita, Kansas

Morton County, Sec. 2 Twp. 32S Rge. 41 / (E) W (W)

Location as "NE/CNW%SW%" or footage from lines C/ NE/4
Lease Owner Graham-Michaelis Drilling Co.
Lease Name DEAN Well No. 1
Office Address 1005 E. Second St., Wichita 1, Kansas
Character of Well (completed as Oil, Gas or Dry Hole) Dry Hole
Date well completed 7-9-56 19
Application for plugging filed 8-17-56 19
Application for plugging approved 8-17-56 19
Plugging commenced 8-17-56 19
Plugging completed 8-18-56 19
Reason for abandonment of well or producing formation Dry Hole

NORTH

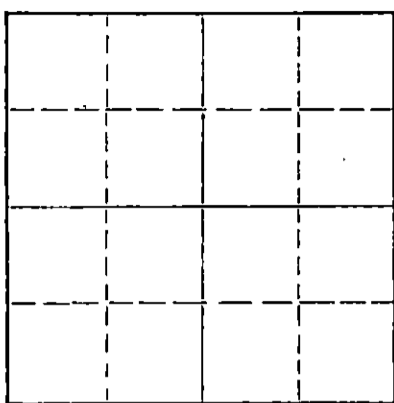

Locate well correctly on above
Section Plat

If a producing well is abandoned, date of last production _____ 19
Was permission obtained from the Conservation Division or its agents before plugging was commenced? Yes

Name of Conservation Agent who supervised plugging of this well Merle Rives, Pratt, Kansas
Producing formation Winfield Depth to top 2217' Bottom _____ Total Depth of Well 2280' Feet
Show depth and thickness of all water, oil and gas formations.

OIL, GAS OR WATER RECORDS

CASING RECORD

FORMATION	CONTENT	FROM	TO	SIZE	PUT IN	PULLED OUT
Shale, Sand & Red Bed		0	442'	8-5/8"	442'	Cement Circulated
Red Bed, Gyp, Sand, Shale & Anhydrite		0	2278'	5-1/2"	2278'	755'

Describe in detail the manner in which the well was plugged, indicating where the mud fluid was placed and the method or methods used in introducing it into the hole. If cement or other plugs were used, state the character of same and depth placed, from _____ feet to _____ feet for each plug set.

Plugged back with crushed rock to 2170', dumped 5 sax cement with dump bailer. Top of cement, 2140'. Pumped in 15 sax of Gel-Mud @ 750' by Sun Cementing Co. Set rock bridge @ 440', dumped 20 sax cement. Top of cement 375'. Filled hole with mud to 35', set rock bridge, dumped 10 sax cement for cap.

RECEIVED
STATE CORPORATION COMMISSION
SEP 22 1956
CONSERVATION DIVISION
Wichita, Kansas

(If additional description is necessary, use BACK of this sheet)

Name of Plugging Contractor Miller Casing Pulling Company,
Address P. O. Box 711, Great Bend, Kansas.

STATE OF KANSAS, COUNTY OF SEDGWICK, ss.

W. A. Michaelis, Jr. (employee of owner) or (owner or operator) of the above-described well, being first duly sworn on oath, says: That I have knowledge of the facts, statements, and matters herein contained and the log of the above-described well as filed and that the same are true and correct. So help me God, GRAHAM-MICHAELIS DRILLING CO.

(Signature) W. A. Michaelis, Jr. Managing Partner.
1005 E. Second St., Wichita, Kansas
(Address)

SUBSCRIBED AND SWORN to before me this 18th day of September, 19 56.

Mary L. Barnes
Notary Public.

My commission expires 11/7/57.

PLUGGING
FILE SEC. 2 T. 32 R. 41
BOOK PAGE 90 LINE 11

COPY

DEAN #1

Well Record

Location: C/ NE/4 Section 2-32S-41W
Morton County, Kansas

Operator: Graham-Michaelis Drilling Co.
1005 East Second Street
Wichita 1, Kansas

Contractor: Graham-Michaelis Drilling Co.
1005 East Second Street
Wichita 1, Kansas

Casing Record: 8-5/8" @ 442.05' w/250 sacks cement
5-1/2" @ 2278' w/300 sacks cement

Commenced: July 5, 1956
Completed: July 9, 1956
(rotary)

LOG

Shale & Sand	370
Shale & Red Bed	445
Red Bed & Gyp.	684
Red Sand & Shale	995
Sand & Shale	1885
Shale & Anhydrite	2280, RTD

Krider 2176
Winfield 2217

STATE OF KANSAS)
) ss.
COUNTY OF SEDGWICK)

The undersigned, GRAHAM-MICHAELIS DRILLING COMPANY, hereby certifies that the above log is a true and correct log of the formations encountered in drilling the above well as reflected by the Daily Drilling Report.

GRAHAM-MICHAELIS DRILLING COMPANY

By John L. James
John L. James
Geologist

Subscribed and sworn to before me
this 19th day of July, 1956.

Mary L. Barney
My commission expires: 11/7/57.

RECEIVED
STATE CORPORATION COMMISSION
SEP 22 1956
CONSERVATION DIVISION
Wichita, Kansas

PLUGGING
FILE SEC. 2 T. 32 R. 41W
BOOK PAGE 90 LINE 11