


15-129-10002-0000

WELL PLUGGING RECORD

Give All Information Completely
Make Required Affidavit
Mail or Deliver Report to:
Conservation Division
State Corporation Commission
211 No. Broadway
Wichita, Kansas

Morton County, Sec. 4 Twp. 32 Rge. 41 (E) W (W)

Location as "NE/CNWKSWK" or footage from lines C/ SE/4
Lease Owner Bovaird Supply Company
Lease Name Clairdge
Office Address 525 S. Western, Liberal, Kansas Well No. 1 67901
Character of Well (completed as Oil, Gas or Dry Hole) Gas Well
Date well completed 10/10/62 19
Application for plugging filed 19
Application for plugging approved 19
Plugging commenced 6/7/ 1969
Plugging completed 10:30 a.m. 6/11/ 1969
Reason for abandonment of well or producing formation
Production declined to uneconomic level.
If a producing well is abandoned, date of last production April 19 69
Was permission obtained from the Conservation Division or its agents before plugging was commenced? Yes

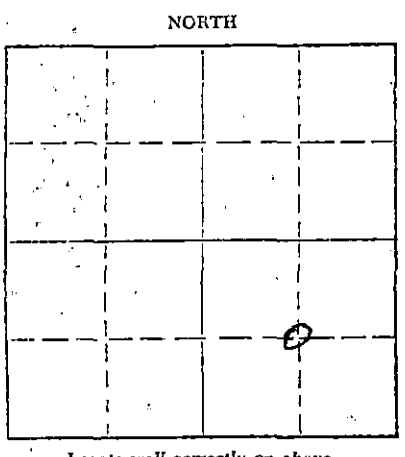

Locate well correctly on above Section Plat

Name of Conservation Agent who supervised plugging of this well
Producing formation Morrow Depth to top 5192 Bottom 5199 Total Depth of Well 5380 Feet
Show depth and thickness of all water, oil and gas formations.

OIL, GAS OR WATER RECORDS

CASING RECORD

FORMATION	CONTENT	FROM	TO	SIZE	PUT IN	PULLED OUT
Morrow	Gas	5192	5199	8 5/8	1520	
				5 1/2	5380	

Describe in detail the manner in which the well was plugged, indicating where the mud fluid was placed and the method or methods used in introducing it into the hole. If cement or other plugs were used, state the character of same and depth placed, from feet to feet for each plug set.

20 sks. on bottom
Top of cement 5,000'
Spot 35 sks. 900' to 800'
Plug and 15 sks. 45' to 0'

Pulled 3,812.48' - 5 1/2"


RECEIVED
STATE CORPORATION COMMISSION
JUL 8 1969
CONSERVATION DIVISION
Wichita, Kansas

(If additional description is necessary, use BACK of this sheet)
Name of Plugging Contractor Sargent's Casing Pulling Service
Address P. O. Box 506, Liberal, Kansas 67901

STATE OF KANSAS, COUNTY OF SEWARD, ss.
Chester A. Nordling (employee of owner) or (owner or operator) of the above-described well, being first duly sworn on oath, says: That I have knowledge of the facts, statements, and matters herein contained and the log of the above described well as filed and that the same are true and correct. So help me God.

(Signature) Chester A. Nordling, Partner
Liberal, Kansas (Address)

Subscribed and sworn to before me this 16th day of June, 1969
My Commission Expires Jan. 22, 1973
Mary Ann Stoddard Notary Public

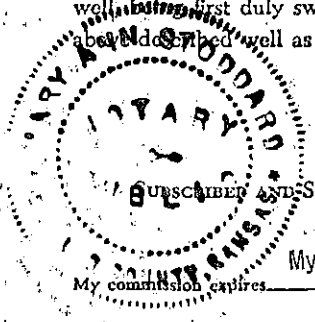

ALAMO CORPORATION
CLARIDGE #1

C SE/4 Section 4-32-41W
Morton County, Kansas

R.T.D. 5381'

CONTRACTOR: Roberts Drilling Co.

Commenced 1/24/62
Completed 2/10/62

Set 8 5/8" Csg. @ 1491' w/700 sx cmt.
Set 5 1/2" Csg. @ 5381' w/100 sx cmt.

Surface Soil & Sand Streaks	163
Sand	190
Red Bed	300
Shale & Shells	383
Red Bed	609
Gypsum & Anhydrite	840
Red Bed	900
Red Bed & Sand	1000
Gypsum & Anhydrite	1075
Gypsum Shale & Anhydrite Streaks	1095
Shale & Anhydrite Streaks	1300
Red Bed & Shale	1474
Anhydrite	1520
Anhydrite & Red Bed	1550
Red Bed & Shale	1610
Red Bed, Sandy Shale & Shale	1875
Red Bed & Shale	2190
Shale & Lime Streaks	2595
Shale & Lime	3365
Lime	3940
Lime & Shale	4055
Lime	4120
Lime & Shale	4230
Lime	4488
Lime & Shale	4655
Shale	4730
Lime	4735
Lime & Shale	4920
Shale	5010
Lime	5043
Shale	5141
Shale & Lime	5175
Shale & Sand	5213
Shale	5240
Shale & Sand	5285
Lime & Shale	5316
Lime, Sand & Shale	5367
Lime	5381

RECEIVED
STATE CORPORATION COMMISSION
JUN 5 1969
CONSERVATION DIVISION
Wichita, Kansas

STATE OF KANSAS)
RUSSELL COUNTY) SS.

I hereby certify that the above information is correct to the best of my knowledge.

ROBERTS DRILLING CO.
By [Signature]

Subscribed and sworn to before me this 13th day of February, 1962.

[Signature]
Notary Public

My Commission Expires 6/17/62