


STATE OF KANSAS
STATE CORPORATION COMMISSION

WELL PLUGGING RECORD

Give All Information Completely
Make Required Affidavit
Mail or Deliver Report to
Conservation Division
State Corporation Comm.
245 North Water
Wichita, KS 67202

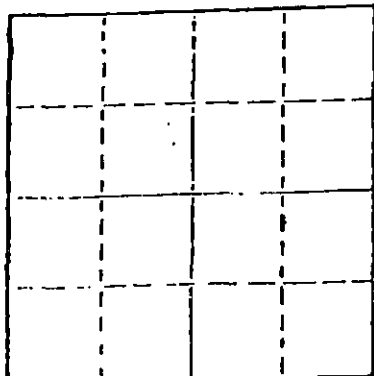

Locate well correctly on above
Section Plot

Clark County, Sec. 26 Twp. 31S Rge. 21W E/W
Location as "NE/CNW $\frac{1}{4}$ SW $\frac{1}{4}$ " or footage from lines
C SE SE SW

Lease Owner Imperial Oil & Gas, Inc.
Lease Name Dammier Well No. 1-26
Office Address 720 Fourth Financial Center, Wichita, KS
Character of Well (Completed as Oil, Gas or Dry Hole)
Dry Hole

Date Well completed 7-12 1984
Application for plugging filed 7-12 1984
Application for plugging approved 7-12 1984
Plugging commenced 7-12 1984
Plugging completed 7-12 1984
Reason for abandonment of well or producing formation
Dry Hole

If a producing well is abandoned, date of last production
N/A 19

Was permission obtained from the Conservation Division or
its agents before plugging was commenced? Yes

Name of Conservation Agent who supervised plugging of this well Steve Durant
Producing formation Depth to top Bottom Total Depth of Well 5234
Show depth and thickness of all water, oil and gas formations.

OIL, GAS OR WATER RECORDS

CASING RECORD

FORMATION	CONTENT	FROM	TO	SIZE	PUT IN	PULLED OUT
				8-5/8"	603KB	

Describe in detail the manner in which the well was plugged, indicating where the mud fluid
was placed and the method or methods used in introducing it into the hold. If cement or other
plugs were used, state the character of same and depth placed, from feet to
feet for each plug set.

50 sacks @ 1020'

50 sacks @ 660'

10 sacks @ 40'

10 sacks in rat hole

10 sacks in mouse hole

By Halliburton

(If additional description is necessary, use BACK of this sheet)

Name of Plugging Contractor Eagle Drilling, Inc.

STATE OF Kansas COUNTY OF Sedgwick, ss.
Robert L. Eisel (employee of owner) or (owner or operator)
of the above-described well, being first duly sworn on oath, says: That I have knowledge of
the facts, statements, and matters herein contained and the log of the above-described well
as filed and that the same are true and correct. So help me God.

(Signature)

P.O. Box 8609, Wichita, KS 67208
(Address)

SUBSCRIBED AND SWORN TO before me this 25th day of July, 1984

My commission expires

8-11-85

Tiffany S. Little Notary Public.



RECEIVED
STATE CORPORATION COMMISSION

JUL 27 1984

CONSERVATION DIVISION
Wichita, Kansas