


STATE OF KANSAS
STATE CORPORATION COMMISSION

WELL PLUGGING RECORD

15-025-26297-0000

Give All Information Completely
Make Required Affidavit
Mail or Deliver Report to
Conservation Division
State Corporation Comm.
245 North Water
Wichita, KS 67202

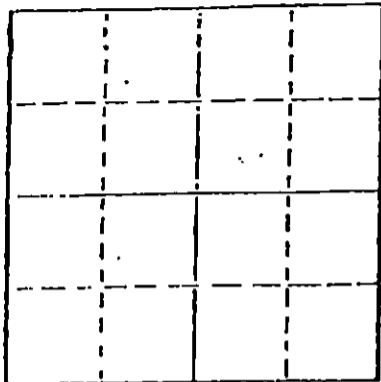

Locate well correctly on above
Section Plat

Clark County. Sec. 28 Twp. 31 Rge. 21 E W
Location as "NE/CNW $\frac{1}{4}$ SW $\frac{1}{4}$ " or footage from lines
C NW NW

Lease Owner Imperial Oil Company
Lease Name Pentz Well No. 1-28
Office Address 720 Fourth Financial Center Wichita, KS 67202
Character of Well (Completed as Oil, Gas or Dry Hole)
Dry Hole

Date Well completed 06-14 1979
Application for plugging filed 06-14 1979
Application for plugging approved 06-14 1979
Plugging commenced 06-14 1979
Plugging completed 06-14 1979

Reason for abandonment of well or producing formation
Dry Hole
If a producing well is abandoned, date of last production
19

Was permission obtained from the Conservation Division or
its agents before plugging was commenced? Yes

Name of Conservation Agent who supervised plugging of this well Bill Owens
Producing formation _____ Depth to top _____ Bottom _____ Total Depth of Well 5350
Show depth and thickness of all water, oil and gas formations.

OIL, GAS OR WATER RECORDS

CASING RECORD

FORMATION	CONTENT	FROM	TO	SIZE	PUT IN	PULLED OUT
				8 5/8	605	-0-

Describe in detail the manner in which the well was plugged, indicating where the mud fluid
was placed and the method or methods used in introducing it into the hold. If cement or other
plugs were used, state the character of same and depth placed, from _____ feet to
_____ feet for each plug-set.

50 Sacks @ 600 ft.
12 Sacks @ 40 ft.
3 Sacks @ Rat Hole

(If additional description is necessary, use BACK of this sheet)

Name of Plugging Contractor Eagle Drilling Inc.

STATE OF Kansas COUNTY OF Sedgwick, ss.
Robert L. Eisel (employee of owner) or (owner or operator)
of the above-described well, being first duly sworn on oath, says: That I have knowledge of
the facts, statements, and matters herein contained and the log of the above-described well
as filed and that the same are true and correct. So help me God.

(Signature) Robert L. Eisel
Robert L. Eisel--260 N. Rock Rd. Suite 210
(Address) Wichita, KS 67206

SUBSCRIBED AND SWORN TO before me this 19th day of June, 1979

Carol Alexander
Carol Alexander Notary Public.
STATE CORPORATION COMMISSION

My commission expires April 7, 1980



JUN 21 1979

CONSERVATION DIVISION
Wichita, Kansas

