


15-025-20559-0000

WELL PLUGGING RECORD

Give All Information Completely
 Make Required Affidavit

COUNTY Clark SEC. 30 TWP. 31S RGE. 21 X&W
 Location as in quarters or footage from lines:

1400' ENL/2100' FEL, Sec 30

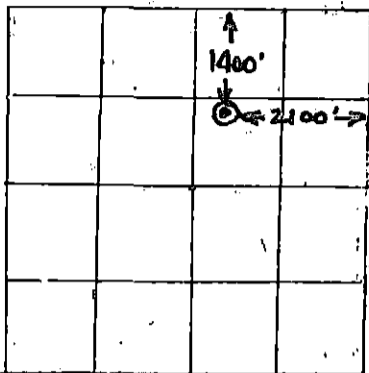

Locate Well
 correctly on above
 Section Platt.

Lease Owner GS Oil & Gas Co.

Lease Name Robt. J. Seacat Well No. 1-30

Office Address 700 Rusk, Suite 501, Houston, Tx 77002

Character of Well (Completed as Oil, Gas or Dry Hole): Dry Hole

Date Well Completed 1-9-82

Application for plugging filed 12-30-81

Plugging commenced 1-9-82

Plugging completed 1-9-82

Reason for abandonment of well or producing formation No

Commercial Hydrocarbon Deposits

Was permission obtained from the Conservation Division or it's
 Agent's before plugging was commenced? Yes

Name of Conservation Agent who supervised plugging of this well _____

Producing formation (No Prod) _____ Depth to top _____ bottom _____ T.D. 5350'

Show depth and thickness of all water, oil and gas formations.

OIL, GAS OR WATER RECORDS

Casing Record

Formation	Content	From	To	Size	Put in	Pulled Out
Topeka Lm	salt wtr	3748	3848		none	
Toronto Lm	" "	4255	4285		none	
Lansing Lm	" "	4440	4462		none	
Pawnee	salt wtr	4970			none	
Mississippi Lm	salt wtr	5143	5350		none	

Describe in detail the manner in which the well was plugged, indicating where the mud fluid was placed and the method or methods used in introducing it into the hold. If cement or other plugs were used, state the character of same and depth placed, from _____ feet to _____ feet for each plug set.

8 5/8" OD Sur Csg Set at 652' & CMTD w/450 sx Cl "H" cmt
40 sx Cl "H" cement plug 648' up to 548'
10 " " " " " 40" up to sur of ground
5 " " " " " in mouse hole
10 " " " " " " rat hole

(If additional description is necessary, use BACK of this sheet)

Name of Plugging Contractor Halliburton Services

STATE OF TEXAS COUNTY OF HARRIS, ss.

John P. Lowe, Jr. (employee of owner) or ~~(owner or operator)~~ of the above-described well, being first duly sworn on oath, says: That I have knowledge of the facts, statements, and matters herein contained and the log of the above-described well as filed and that the same are true and correct. So help me God.

(Signature) [Signature]
700 RUSK, ST. 501, HOU. TX 77002
 (Address)

SUBSCRIBED AND SWORN TO before me this 1st day of February, 19 82

[Signature]
 STATE CORPORATION COMMISSION Public.

My Commission expires: 7/31/84

FEB - 4 1982 2-4-82

DRILLER'S LOG

15-025-20559-0000

Operator: GS Oil & Gas Co.
Well Name: Seacat #1-30
Well Location: 1400' from N line, 2100' from E line
Sec. 30-31S-21W
County, State: Clark County, Kansas

Commenced: 12-27-81
Completed: 01-09-82

Surface Casing: Ran 15 jts new 24 lb. 8 5/8"
casing. Set at 652' KB. Cemented with 300 sacks
2% cc, 1/4 lb. flow seal. Followed with 150 sacks
Class H, 3% cc.

FORMATION

DEPTH

Red Bed	85-745
Shale & Shells	745-1520
Shale & Lime	1520-3860
Lime & Shale	3860-4040
Shale & Lime	4040-4245
Lime & Shale	4245-4445
Lime	4445-4470
Lime & Shale	4470-4580
Lime	4580-5350
R.T.D.	5350

RECEIVED
STATE CORPORATION COMMISSION
JAN 20 1982
CONSERVATION DIVISION
Wichita, Kansas

I do hereby certify that the foregoing statements are true and correct to the best of my knowledge and belief.

EAGLE DRILLING, INC.
Robert L. Eisel
Robert L. Eisel
Vice-President

TIFFANY S. LITTLE
NOTARY PUBLIC
STATE OF KANSAS
MY APPT. EXPIRES 8-11-85

STATE OF KANSAS)
COUNTY OF SEDGWICK) ss:

Subscribed and sworn to before me this 18th day of January, 1982.

My appointment expires: 8-11-85

Tiffany S. Little
Notary Public Tiffany S. Little