

STATE OF KANSAS
STATE CORPORATION COMMISSION


WELL PLUGGING RECORD

15-025-25112-0000

Give All Information Completely
Make Required Affidavit
Mail or Deliver Report to
Conservation Division
State Corporation Comm.
245 North Water
Wichita, KS 67202

Clark County, Sec. 33 Twp. 31S Rge. 21 E/W
Location as "NE/CNW $\frac{1}{4}$ SW $\frac{1}{4}$ " or footage from lines NW SW

Lease Owner Reading & Bates Oil and Gas Co.
Lease Name Vallentine Well No. 1
Office Address 3800 First Place Tower, Tulsa, Okla. 74103
Character of Well (Completed as Oil, Gas or Dry Hole)

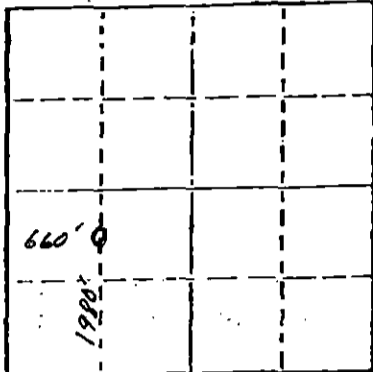

Locate well correctly on above
Section Plot

Dry Hole
Date Well completed 19
Application for plugging filed (written) 6-30 1976
Application for plugging approved Verbal 6-29-1976
Plugging commenced 6-29 1976
Plugging completed 6-29 1976
Reason for abandonment of well or producing formation

If a producing well is abandoned, date of last production 19

Was permission obtained from the Conservation Division or its agents before plugging was commenced? Yes

Name of Conservation Agent who supervised plugging of this well Clarence Thomas
Producing formation Depth to top Bottom Total Depth of Well 5344'
Show depth and thickness of all water, oil and gas formations.

OIL, GAS OR WATER RECORDS

CASING RECORD

FORMATION	CONTENT	FROM	TO	SIZE	PUT IN	PULLED OUT

Describe in detail the manner in which the well was plugged, indicating where the mud fluid was placed and the method or methods used in introducing it into the hold. If cement or other plugs were used, state the character of same and depth placed, from feet to feet for each plug set.

50 sx. regular cement plug @ 600'
15 sx. plug from 40-0'
5 sx. each in mouse and rat holes.

RECEIVED

STATE CORPORATION COMMISSION

JUL 02 1976

CONSERVATION DIVISION
Wichita, Kansas

(If additional description is necessary, use BACK of this sheet)

Name of Plugging Contractor Rine Drilling Company
300 W. Douglas, Suite 600 - Wichita, Kansas 67202

STATE OF Oklahoma COUNTY OF Tulsa, ss.
Paul G. Farrow (employee of owner) or (owner or operator)
of the above-described well, being first duly sworn on oath, says: That I have knowledge of the facts, statements, and matters herein contained and the log of the above-described well as filed and that the same are true and correct. So help me God.

(Signature) Paul G. Farrow
3800 First Place Tower, Tulsa, Oklahoma
(Address) 74103

SUBSCRIBED AND SWORN TO before me this 30th day of June, 1976

Viginia Boudale
Notary Public.

My commission expires November 16, 1978